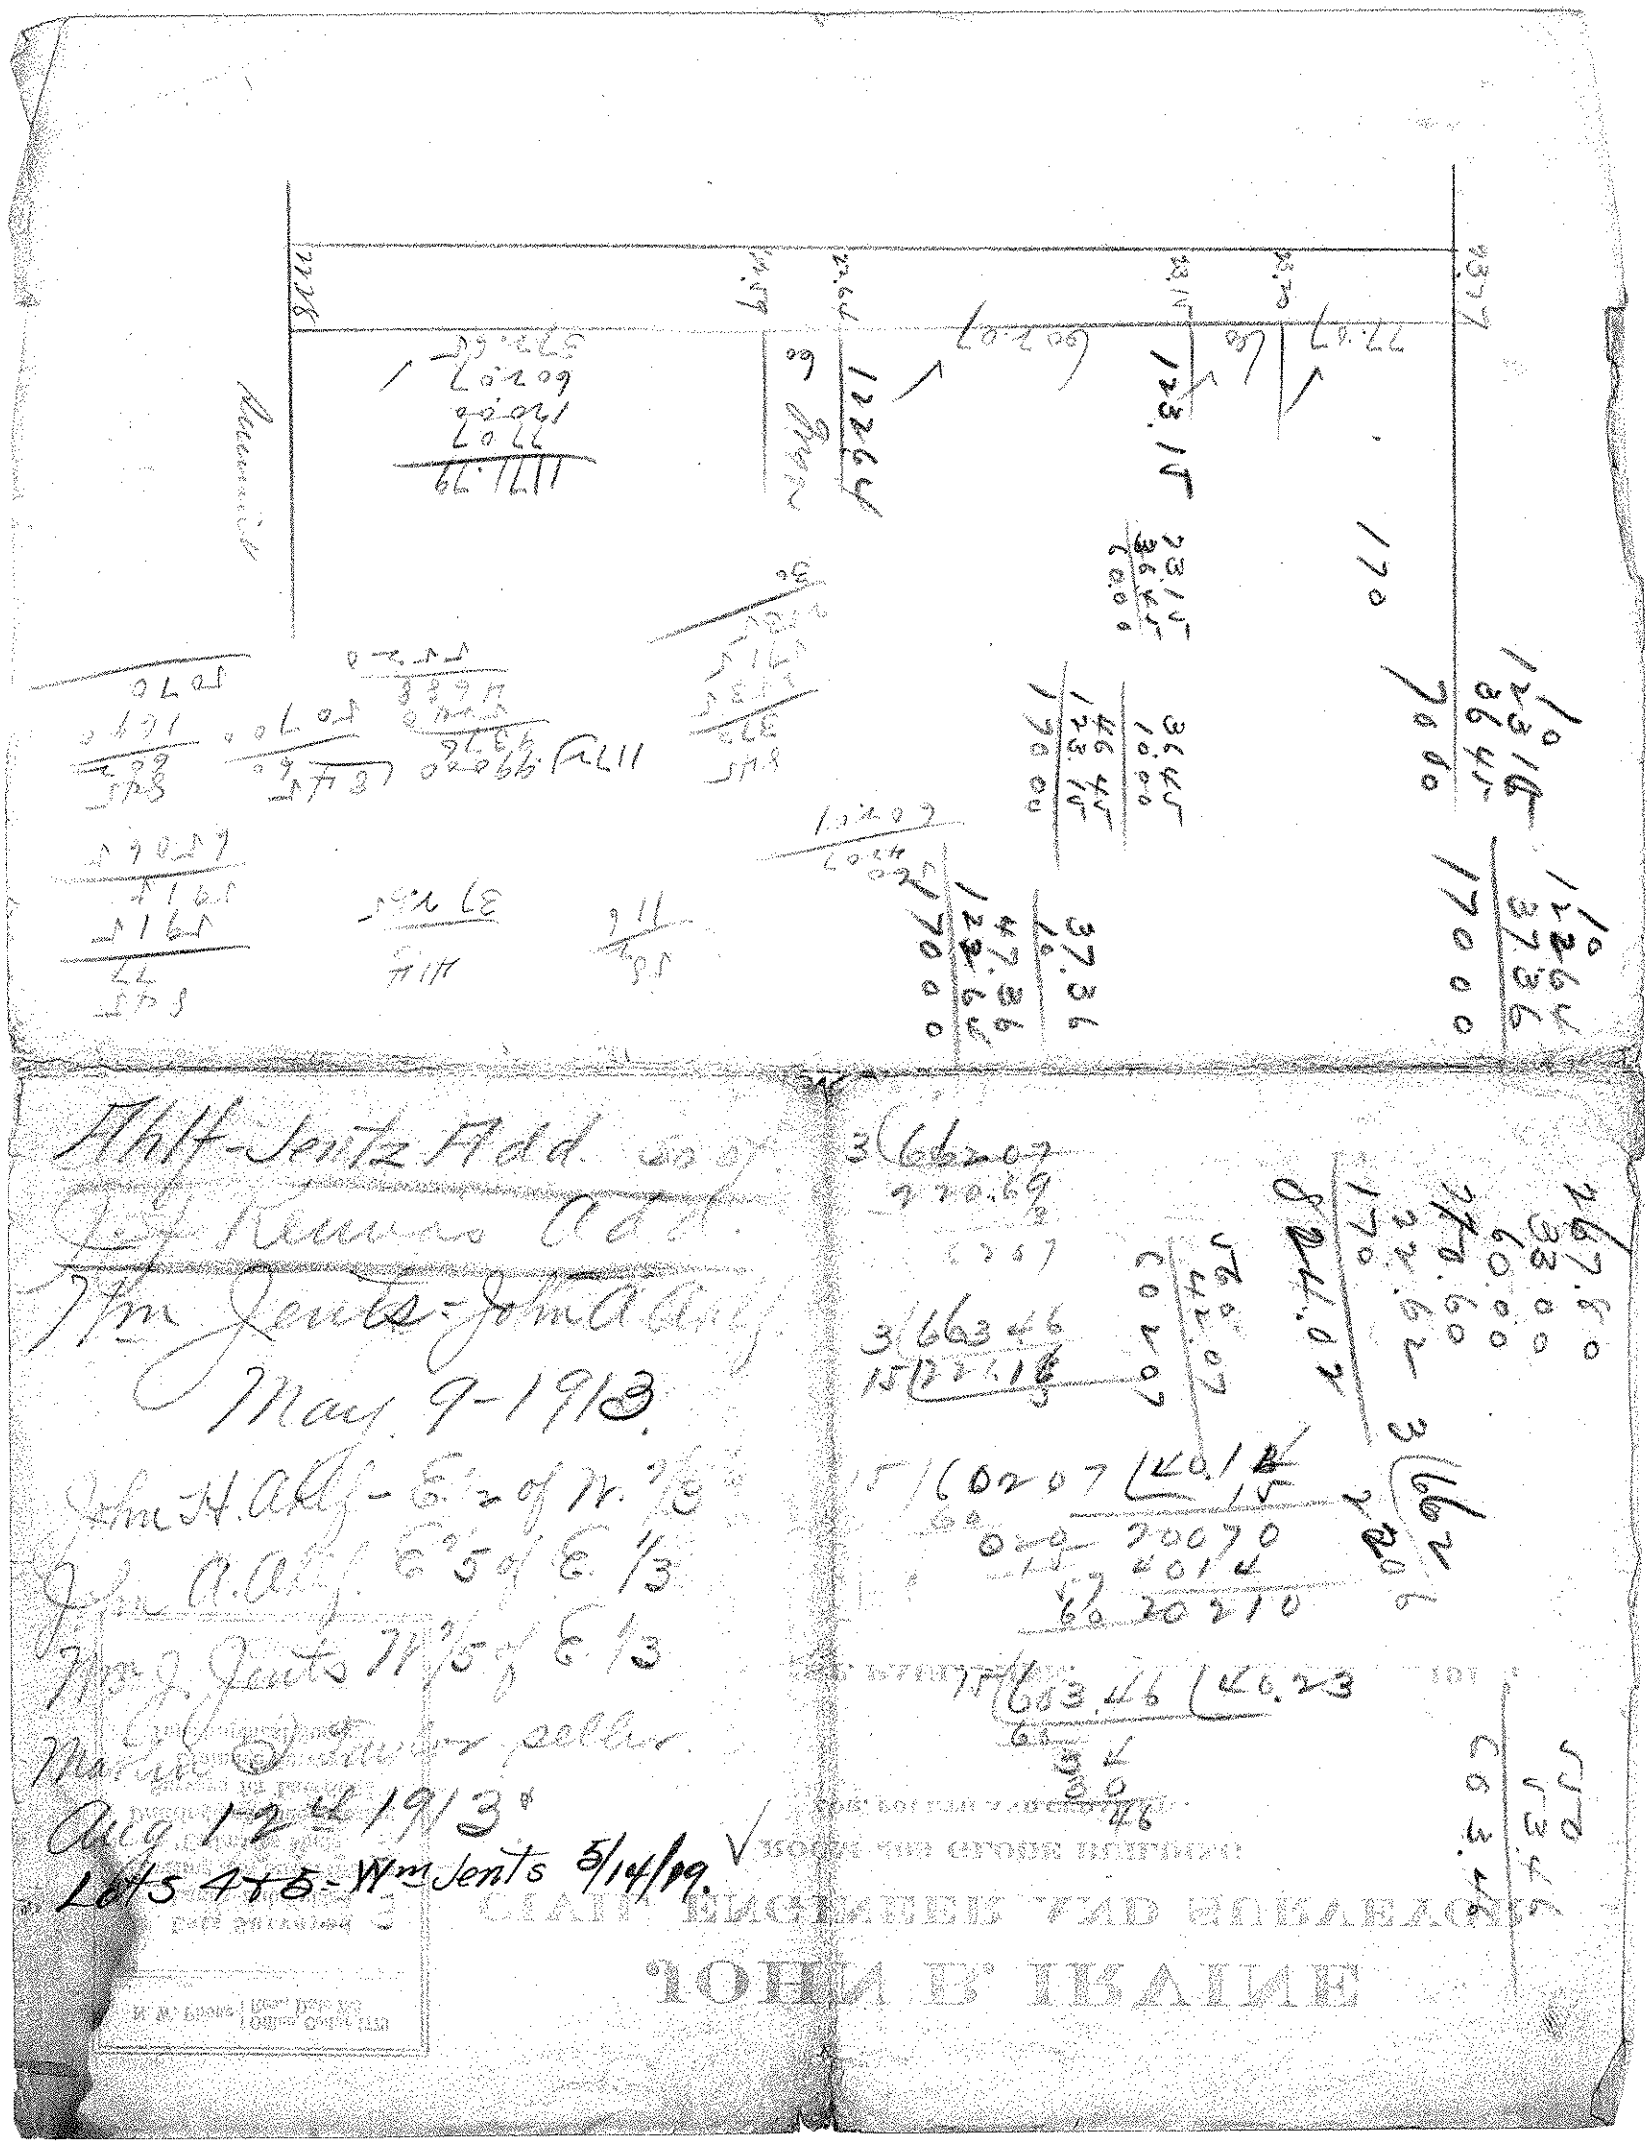

Ahlf-Jentz Add. to
Wm Jents - John Ahlf
May 9-1913
John A. Ahlf E½ of E ⅓
Wm J. Jents W½ of E ⅓
Aug 12 1913
Lots 4 & 5 - Wm Jents 5/14/19.