875
920.20
9625

3768
2061
4207

268
60
21780

303
60
43560 / 1818.00 (.41)
174240
65600

241.75
60
181.75
40
43560 / 7270.00 (.16)
43560
29410

4.59
.16
4.43

Anna K. Roenig
excp pt taken for Randolph.
+Snelling Ave..
N. 1/3 lots 1 & 2. Sec 10-28-23

Ida K. Dalbach.
excp Snelling Ave.
S. 1/3. lots 1 & 2. 10-28-23

Theresa Hinckel
Excp pt taken for Randolph.
Lot 3. Sec 10-28-23 5 ac.

Geo. Trenton
Exch N. 40' of N. 120' ±
excp Randolph St.
That pt. L. & lg. wly. of a line
des as fol - Beg. at a on E. & N.
1/4 Sec. l. 40' N. of NE cor. said L.
th S. = with E. l. lot 4 11.79 chs.
th S. 45° W. 2.626 chs to a on S. l.
l. & 2.465 chs W. of SE. cor.
said lot & Sec. 1 -
3.89 ac.

Mary & Ida Rankin
Excp Rand. St.
The N. 40 f. of N. 160 ft ±
lot 4. - 0.11 ac.

241.75
46
19670.00

320

JOHN B. IRVINE,
Civil Engineer and Surveyor,
Room 408 Globe Building.
4th and Cedar Sts.
ST. PAUL, - MINN.

Hurt Property
N. W. 1/4 S. W. 1/4
Sec. 10-28-23

JOHN B. IRVINE,
Civil Engineer and Surveyor,
Room 408 Globe Building.
4th and Cedar Sts.
ST. PAUL, - MINN.

3.6663
21978.
NW 1.776
3.6663
1776.522
1776.522
0.0032

3.6663
21978.
241.75
967.04
Rand. St.
13197 ac
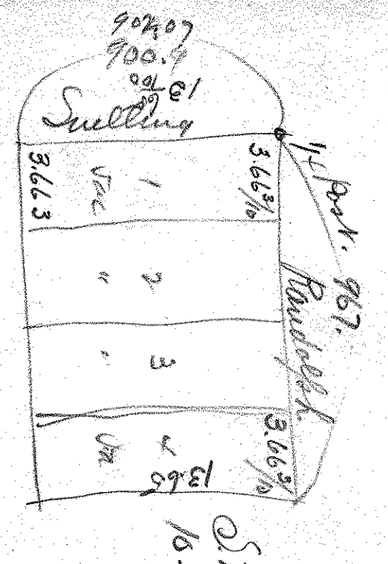
S. H. R. 2