SE 8 28 23 2

PLAT OF SURVEY

Appl. 28818

EDWARD C. COHEN

The South 125.71 feet lying immediately South of the South Line of Randolph Ave. of East 60 feet of the West 390 feet of the North half of the NE 1/4 of the SE 1/4 of Section 8, Township 28, Range 23, subject to public alley.

SCALE: 1" = 30' No 2150 Randolph Ave, St. Paul, Minn.

T. J. Welch
Registered Surveyor
738 Surrey Ave.
ST. PAUL, 6, MINN.
TEL. PR6-0640
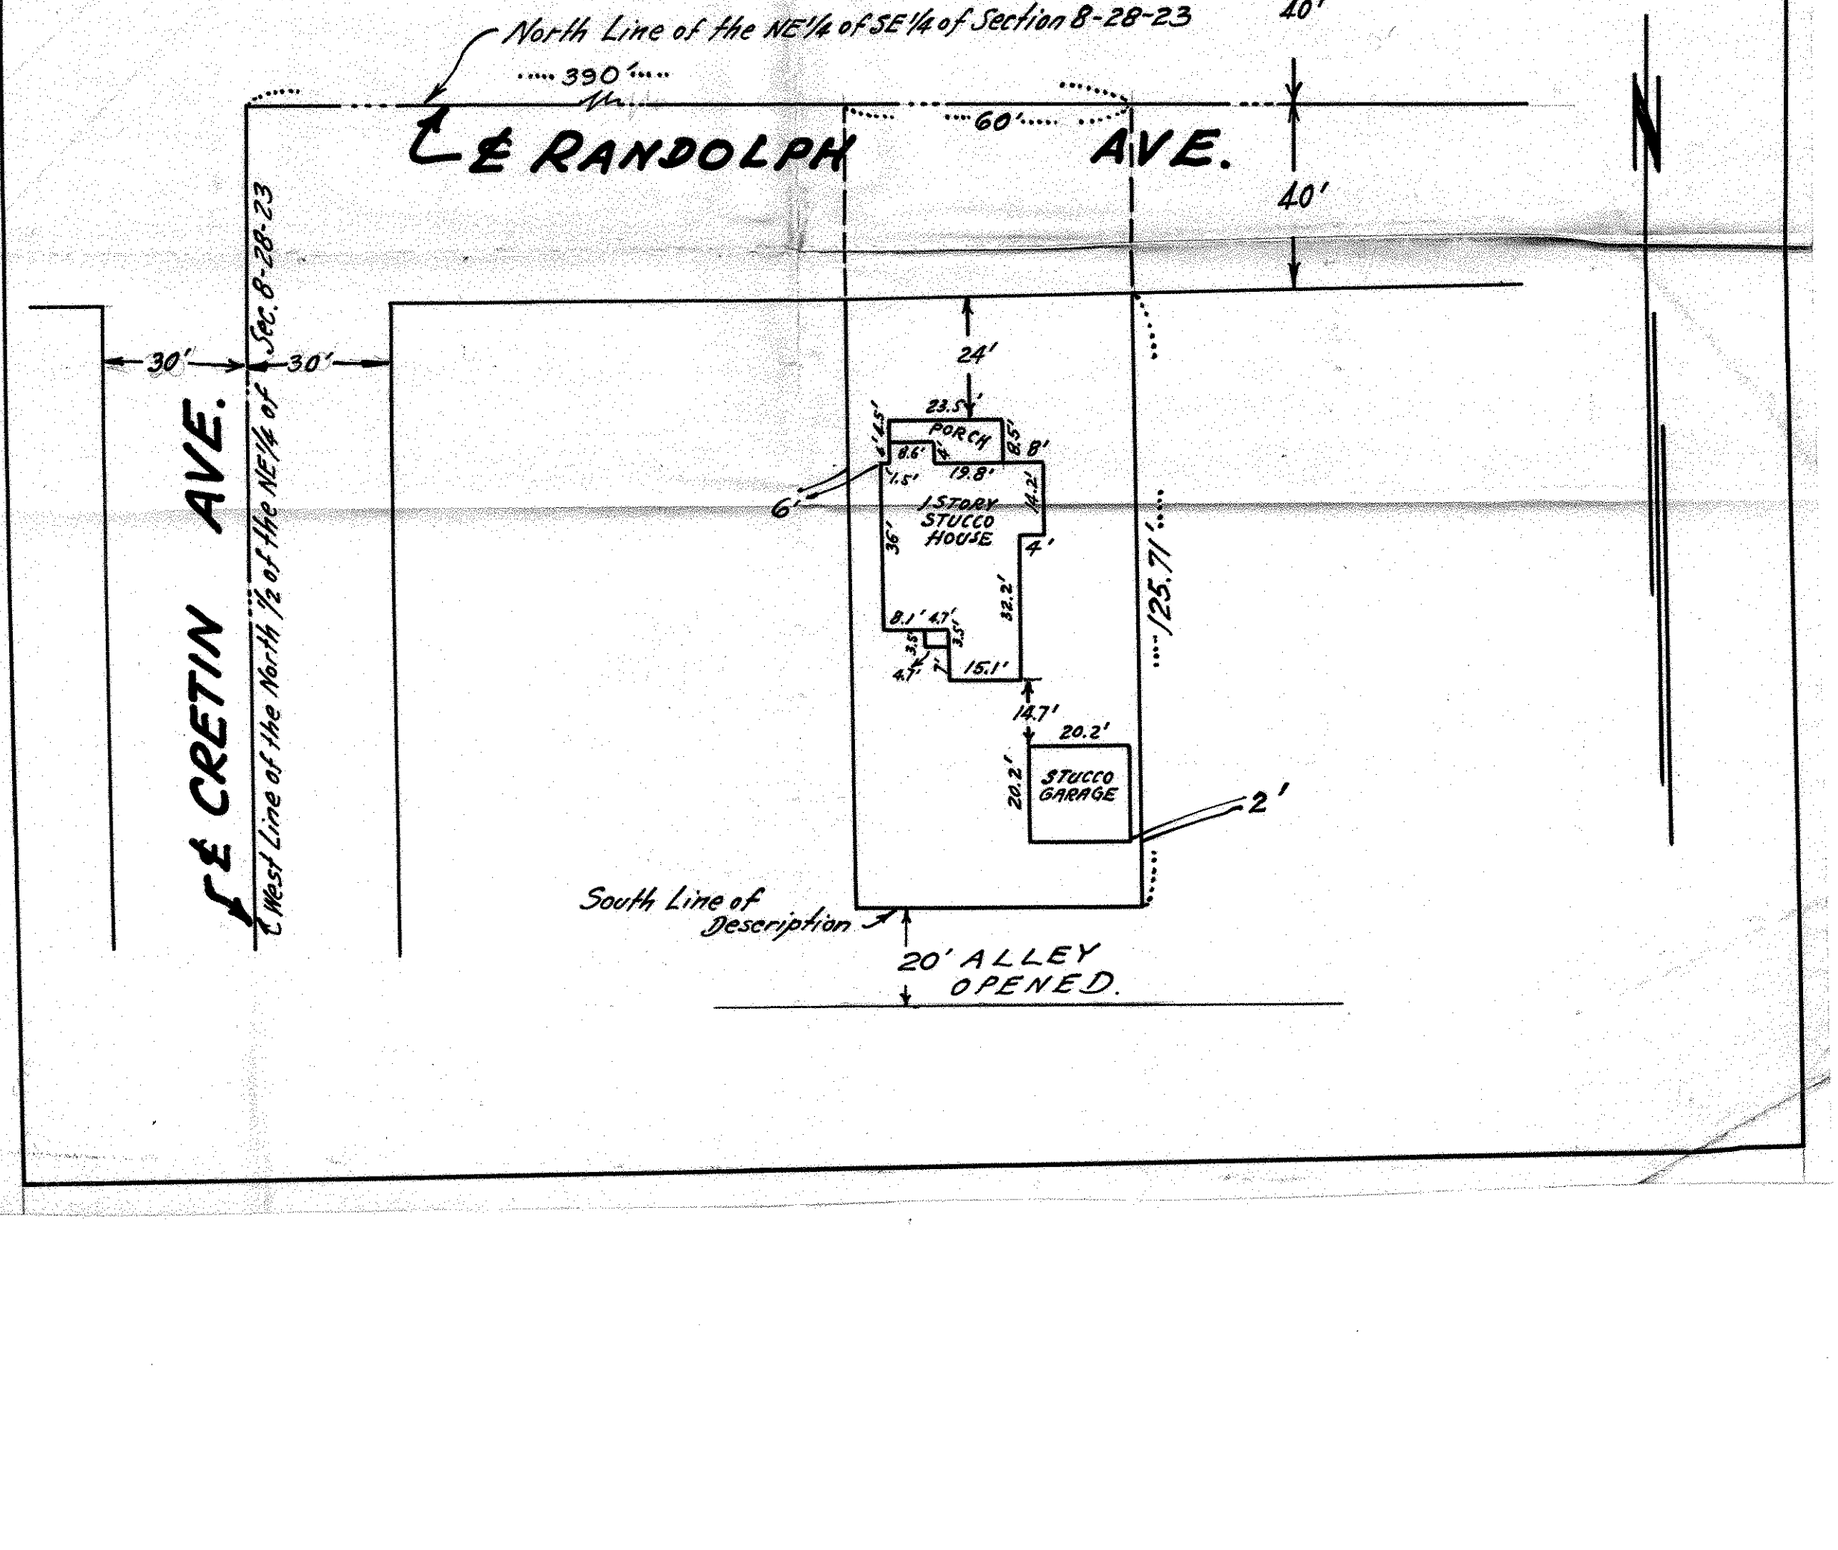
2-7-1959.