FROM THE OFFICE OF

Certificate of Survey

CHARLES O. GEORGI COMPANY

2215 West County Road B

Saint Paul 13, Minnesota

REGISTERED CIVIL ENGINEER AND LAND SURVEYOR

 $I\ Hereby\ Certify\ that$ this plat shows a survey made by me of the property described on this plat, and that the corners are correctly placed as shown, and that all locations have been correctly shown.

IMMANUEL LUTHERAN CHURCH


Surveyed For James Foschines - Engineer

Date August 1945

Scale /"= 50'

Description:

The Westerly 50 feet of the South 200 feet of Warwick Ave Vacated lying between Blocks 9 and 10 in Summit Ave. Addition to the City of St Paul.

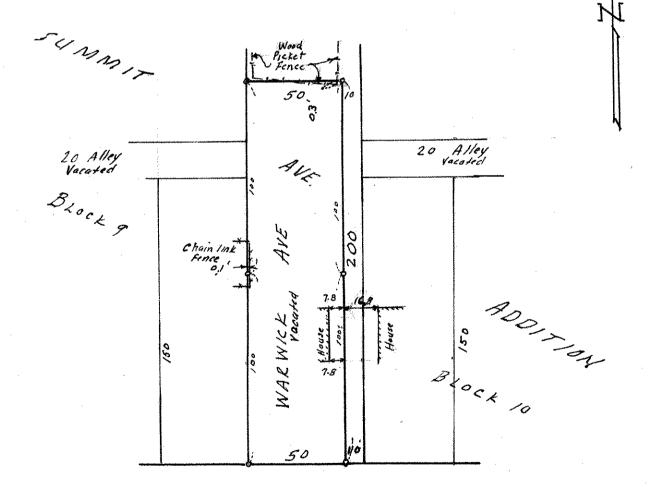

· Denotes from Monument

SUMMIT AVE.