see SW 10 28 23

FROM THE OFFICE OF

# CHARLES O. GEORGI COMPANY

2215 West County Road B Saint Paul, Minnesota 55113

REGISTERED CIVIL ENGINEER AND LAND SURVEYOR

## Certificate of Survey

*I Hereby Certify that* this plat shows a survey made by me of the property described on this plat, and that the corners are correctly placed as shown, and that all locations have been correctly shown. Corners as shown placed 3/68

*Surveyed For* Robert Johnson

*Date* September 1968

*Scale* 1" = 100'

By Charles O. Georgi
REGISTERED LAND SURVEYOR

**Description:** (By Attorney)

The North 200 feet of that part of the NW¼ of SW¼ of Section 10, T28N, R23W lying East of the East line of Warwick St and South of the South line of Randolph Ave.

Together with the West 41 feet of the North 200 feet of that part of the NE¼ of the SW¼ of Section 10 T28N, R23W lying West of the West line of Albert St. and South of the South line of Randolph Ave except the East 250 feet thereof; all in the City of St Paul, Ramsey County, Minn.
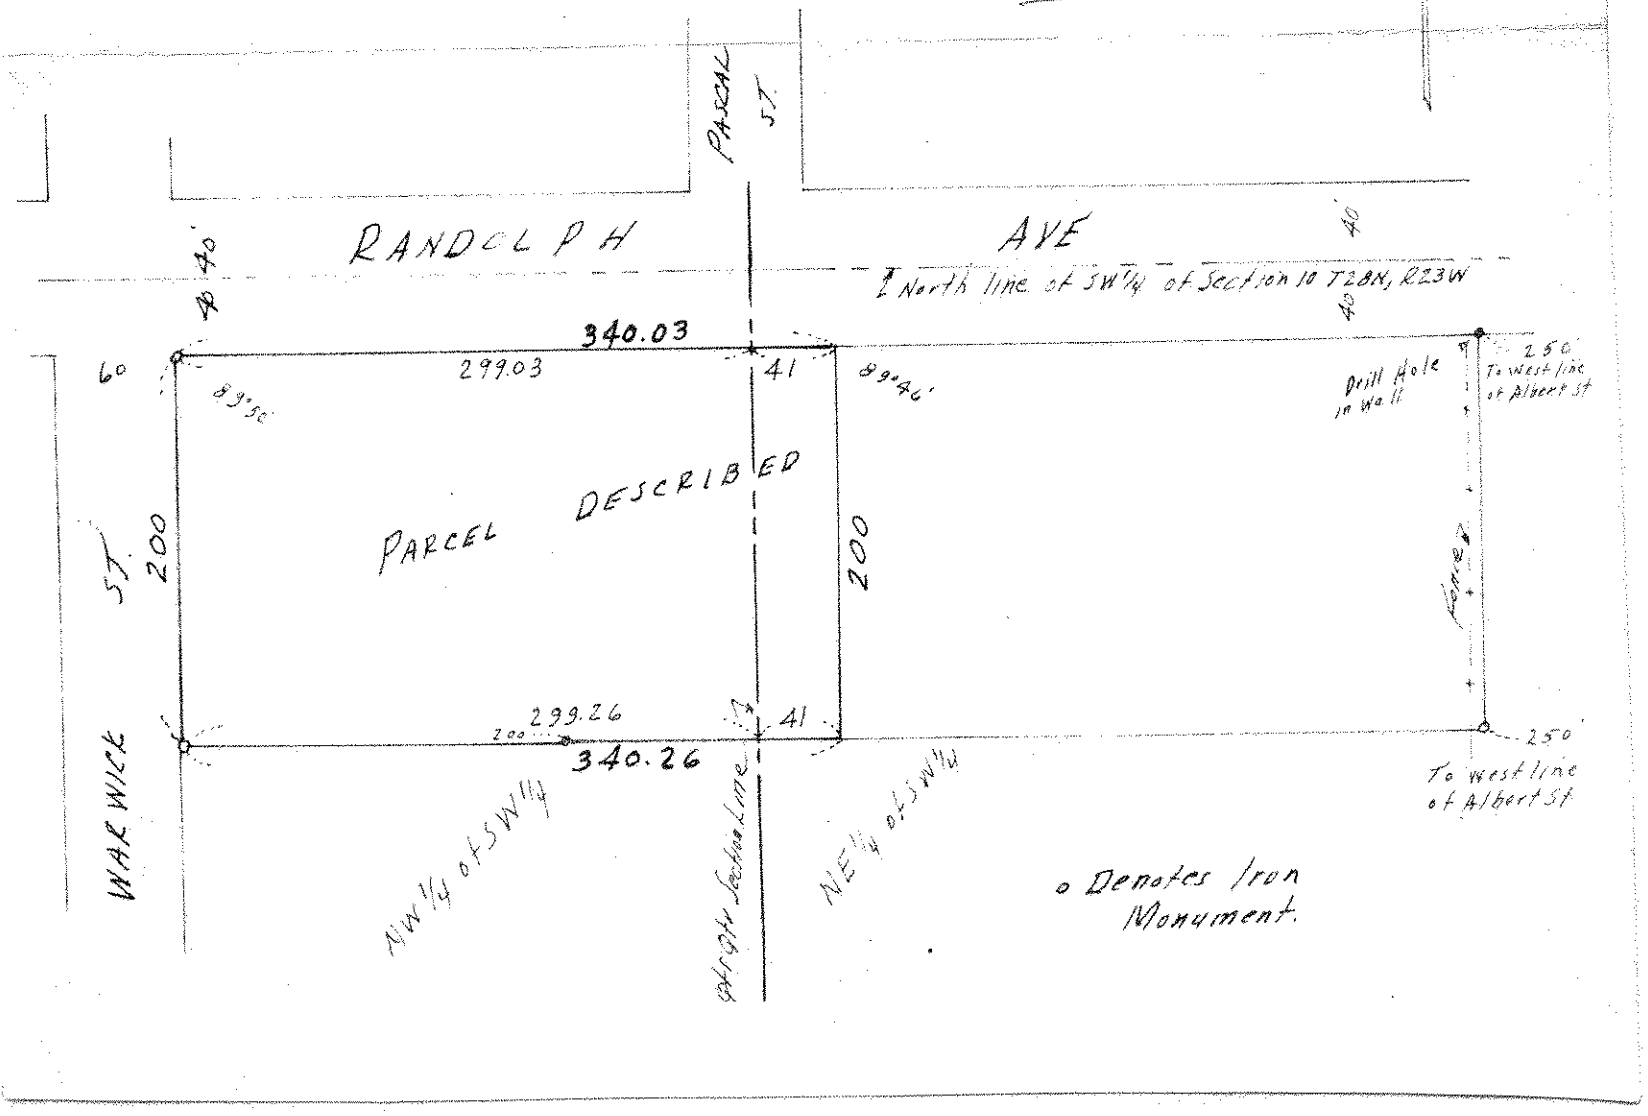
see orphanage
see Convent - Deacon Hall