



TOPOGRAPHIC SURVEY OF MACALESTER COLLEGE

REVISIONS

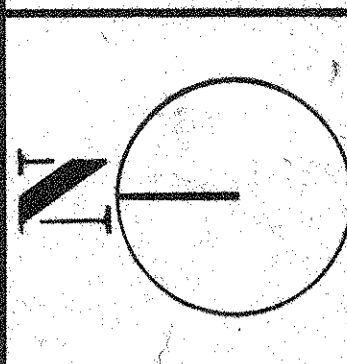

SHEPHERD RICHMOND AND ABBOTT ARCHITECTS 100 WEST STREET ST. PAUL, MINNESOTA 55102	
MACALESTER COLLEGE ST. PAUL, MINNESOTA	
NEW LIBRARY BUILDING	
SITE SURVEY	
SHEET ONE	
DRAWING TITLE	SHEET ONE
JOB NO.	2412
DATE	24 OCT 1926
DRAWN BY	CEB
SCALE	1" = 20.0'

T-9

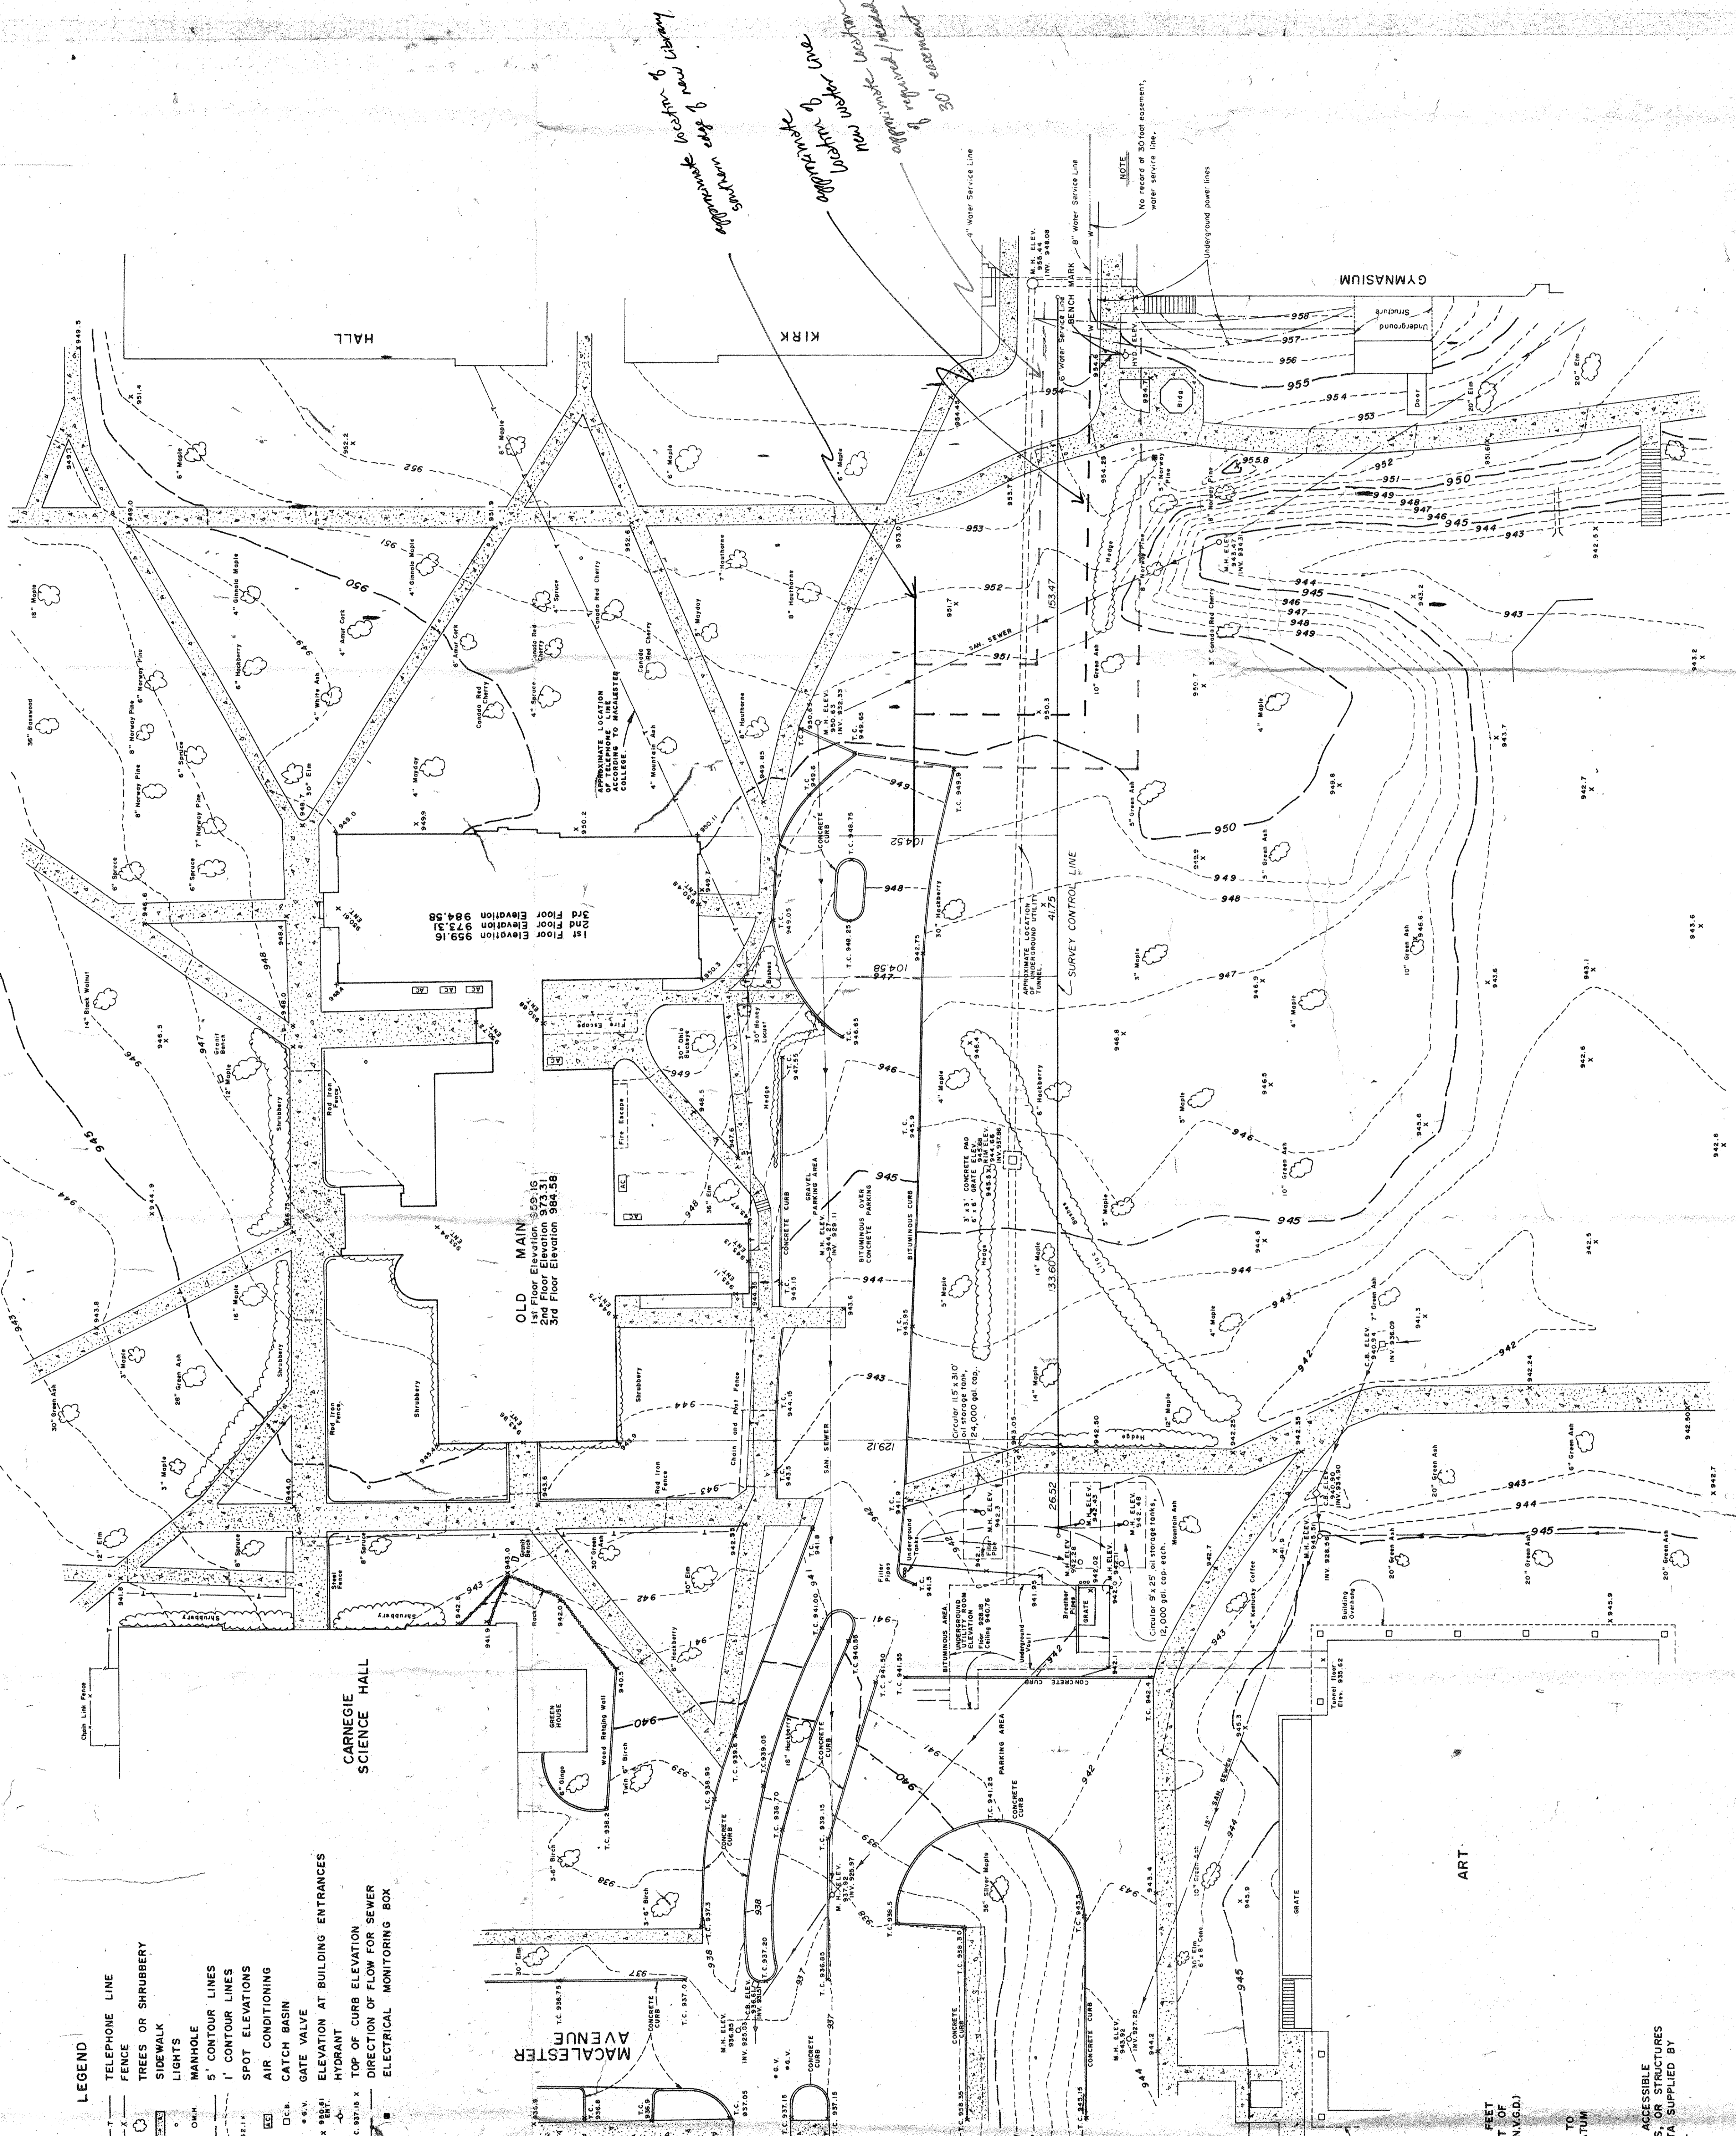

- LEGEND**
- TELEPHONE LINE
 - FENCE OR SHRUBBERY
 - TREES OR SHRUBBERY
 - SIDEWALK
 - LIGHTS
 - MANHOLE
 - 5' CONTOUR LINES
 - 1' CONTOUR LINES
 - SPOT ELEVATIONS
 - AIR CONDITIONING
 - CATCH BASIN
 - GATE VALVE
 - ELEVATION AT BUILDING ENTRANCES
 - HYDRANT
 - TOP OF CURB ELEVATION
 - DIRECTION OF FLOW FOR SEWER
 - ELECTRICAL MONITORING BOX

SCALE 1" = 20'



TUNNEL CONTENTS:
HIGH
MAIN STEAM LINE,
LOW VOLTAGE
LINE, AND PUMP LINE
(CONTROL LINE).

BENCH MARK:
TOP NUT HYDRANT, 3 FEET
NORTH, 17 FEET WEST OF
GYMNASIUM. 997.25 (N.V.G.D.)
1929 DATUM.

CORRECTION FACTOR:
(N.V.G.D.) 1929 DATUM TO
CITY OF ST. PAUL DATUM
-694.10.

NOTE:
THE LOCATION OF NON ACCESSIBLE
UNDERGROUND UTILITIES, OR STRUCTURES
ARE SHOWN FROM DATA SUPPLIED BY
MACALESTER COLLEGE.

I HEREBY CERTIFY THAT THIS PLAN, SPECIFICATION OR REPORT WAS PREPARED BY ME OR UNDER MY CLOSE PERSONAL SUPERVISION AND THAT I AM A DULY REGISTERED LAND SURVEYOR UNDER THE LAWS OF THE STATE OF MINNESOTA.

John E. ...
DATE 1-20-24 REC. NO. 9293

MINNESOTA VALLEY
SURVEYORS & ENGINEERS CORP.
100 EAST CLIFF ROAD
MINNEAPOLIS, MINNESOTA 55401
GRAND HAVENS, MINNESOTA 55124
PHONE: 332-1111

