

LOT 1, SECTION 20, TOWN 28, RANGE 23.

Oct 27th 1904
OCTOBER 1904
ST. PAUL, MINN.

JOHN B. IRVINE
County Surveyor
Room 16 Court House.




MISSISSIPPI RIVER

11 ⁶³/₁₀₀ Acres.

11 ⁶⁵/₁₀₀ Acres.

CITY

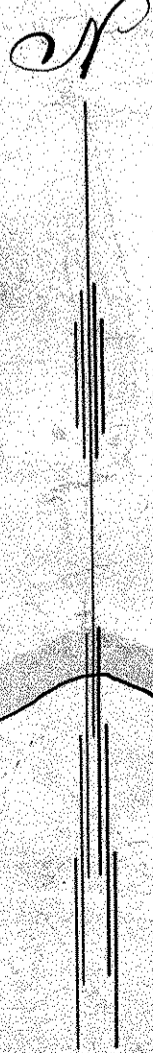

Scale 100 Feet per inch.