
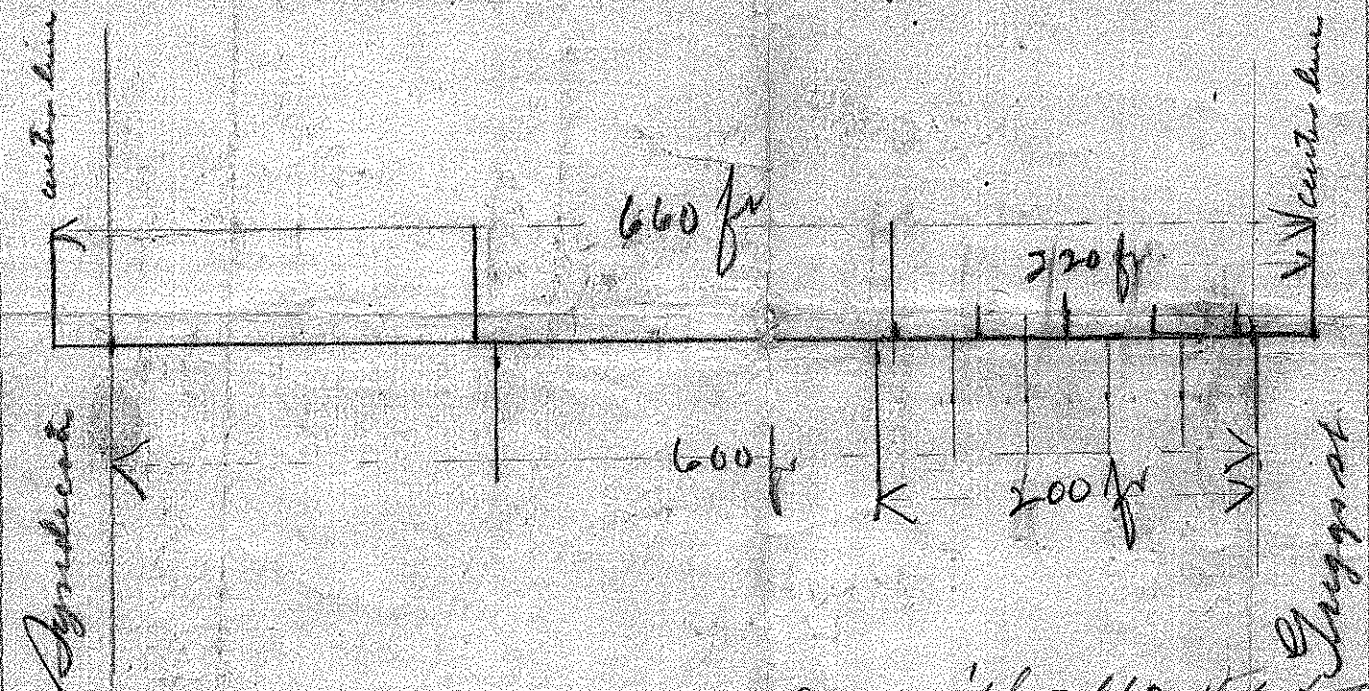


Com. C. Dec 10-78 73 th S. al. 71 + S 1/4 l. 823.87' th E. 663.46 to pt. beg. being
 ly. in c. l. Dynd. Av. prolonged th N. 170' th E. al. S. line Miles or
 in J. J. Kenner add to pt. where same is + by 1/4 Sec. l. being C. L. Griggs at pt. So.
 So. th S. al. pd 1/4 l. or c. l. of Griggs th. pro. to + of pd l. with S. l. of land conveyed
 to Allen McQuillan by 581. Deeds 32. th N. to pt. of beg.

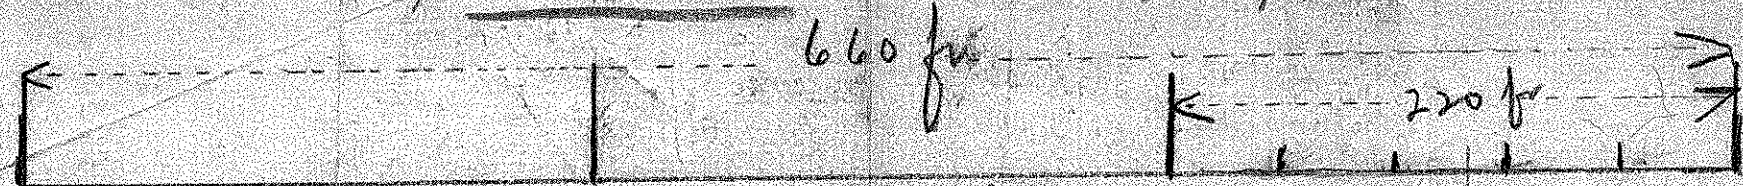

873.87
 170

 653.87

Com. C. Dec 10-78 73 - th S. al. 71 + S 1/4 sec l. 823.87' th E. 663.46 to place of beg. being
 a. ly. in c. of Dynd Av. prol. th N. 170' th E. to a. on c. l. of pd Comm. Av. 653.87' due So.
 of E. + N. 1/4 line of pd Dec 10 th S 10° 5' E. al. pd c. l. of pd " " to a. 873.87' fr. due
 So. of E. + N. 1/4 l. + 1806.78' E. of N + S 1/4 l. th N. 1143.32' fr. to a. on c. l. of Dynd.
 Av. prol. being pt. of beg.