


CAM BRIDGE

314.00

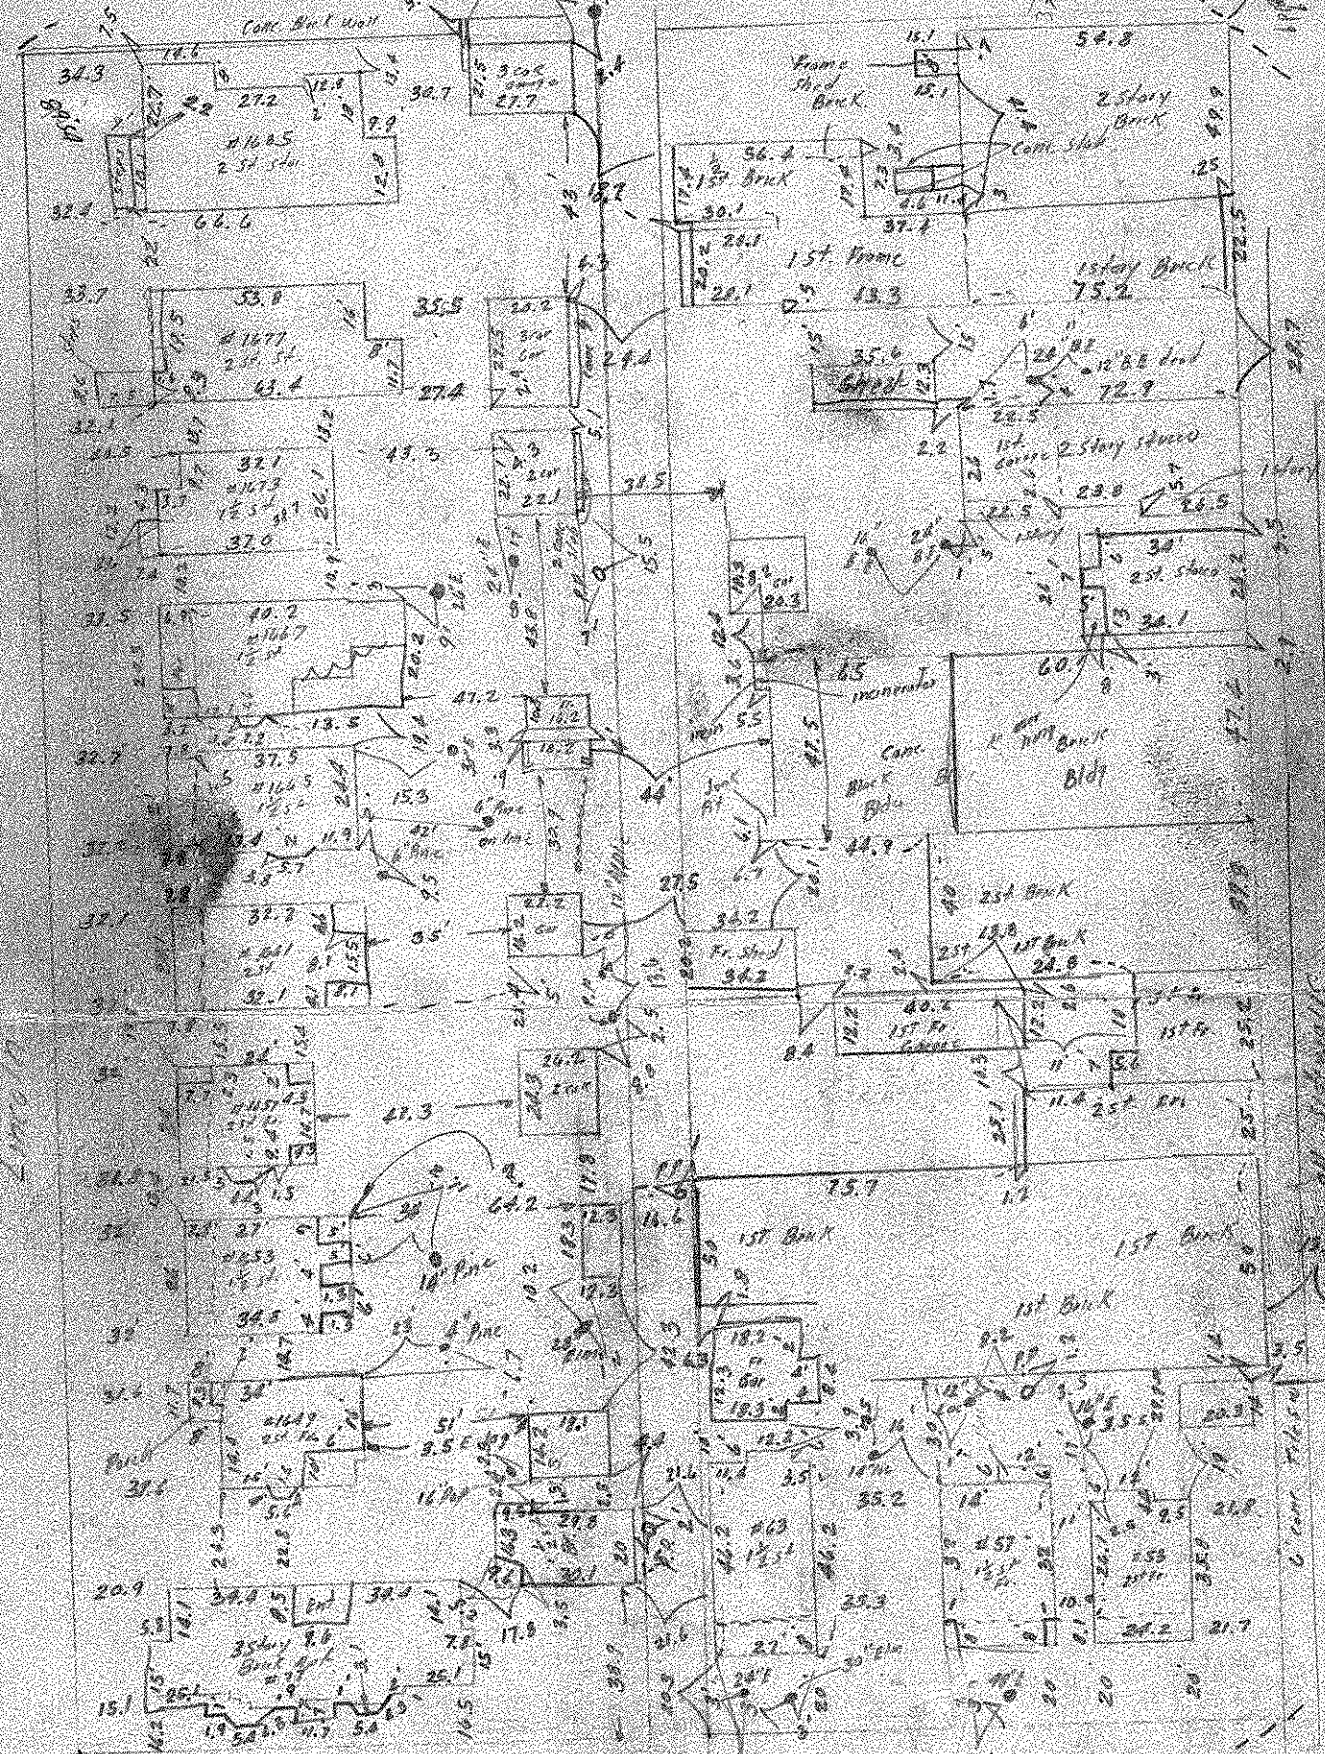

Macomber 11
313.67

Complete

1010
240-6
240-1
AUG 240-6
240-1