

# PLAT OF SURVEY


OF PROPERTY OF

DESCRIBED AS FOLLOWS *Lots 6-7 and 8, Block 3, Kentucky Terrace*

SCALE: 1 INCH = 30 FEET

o DENOTES IRON

T. J. WELCH, REGISTERED SURVEYOR  
701 EAST 3RD STREET, ST. PAUL, MINN. 55106

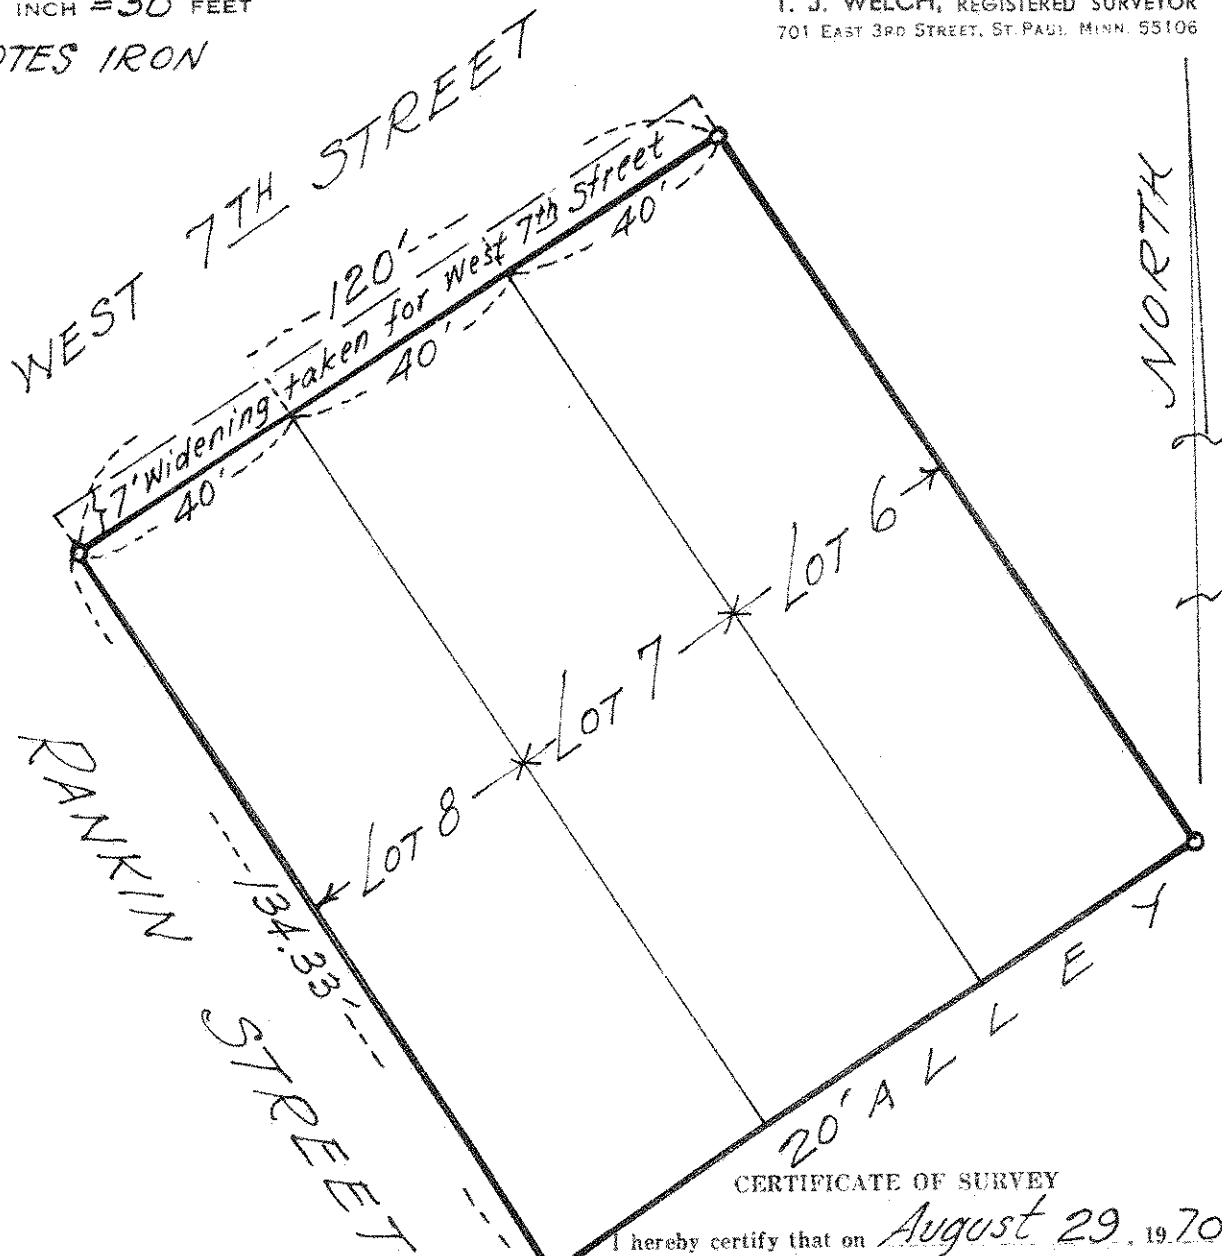

### CERTIFICATE OF SURVEY

I hereby certify that on *August 29, 1970*  
I surveyed the property described above and that the above  
plat is a correct representation of said survey.

*J. J. Welch*