


# PLAT OF SURVEY

OF PROPERTY OF \_\_\_\_\_  
DESCRIBED AS FOLLOWS *Lot 4 and the Southwesterly 25 feet of Lot 3, Block 4,  
Kentucky Terrace.*

SCALE: 1 INCH  $\frac{30}{1}$  FEET  
O DENOTES IRON

T. J. WELCH, REGISTERED SURVEYOR  
738 SURREY AVENUE, ST. PAUL 6, MINN.

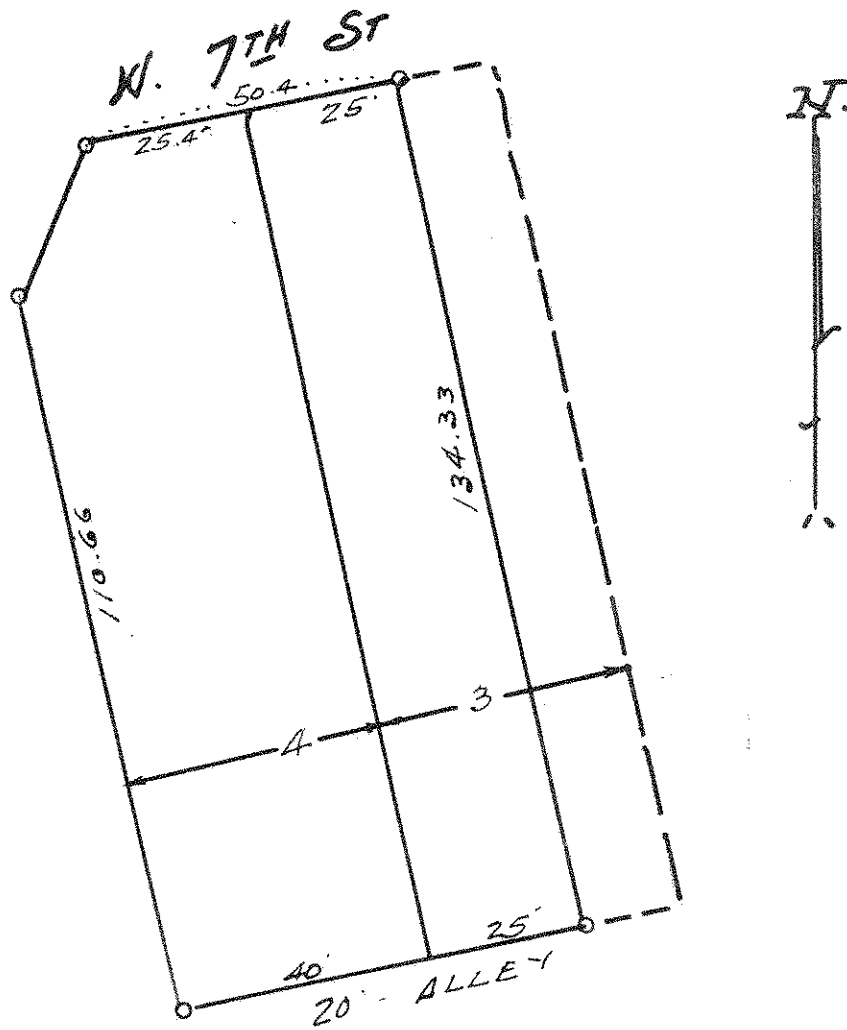

## CERTIFICATE OF SURVEY

I hereby certify that on *9-20* 19*54*  
I surveyed the property described above and that the above  
plat is a correct representation of said survey.

*T. J. Welch*