

TELEPHONE TOWER 0640

PLAT OF SURVEY


OF PROPERTY OF _____

DESCRIBED AS FOLLOWS *Lot 2, except the Northeasterly 7.5' thereof, & all of Lot 3, except the
Southwesterly 25 feet thereof, Block 4, Kentucky Terrace*

SCALE: 1 INCH 30 FEET

O DENOTES IRON

T. J. WELCH, REGISTERED SURVEYOR
738 SURREY AVENUE, ST. PAUL 6, MINN.

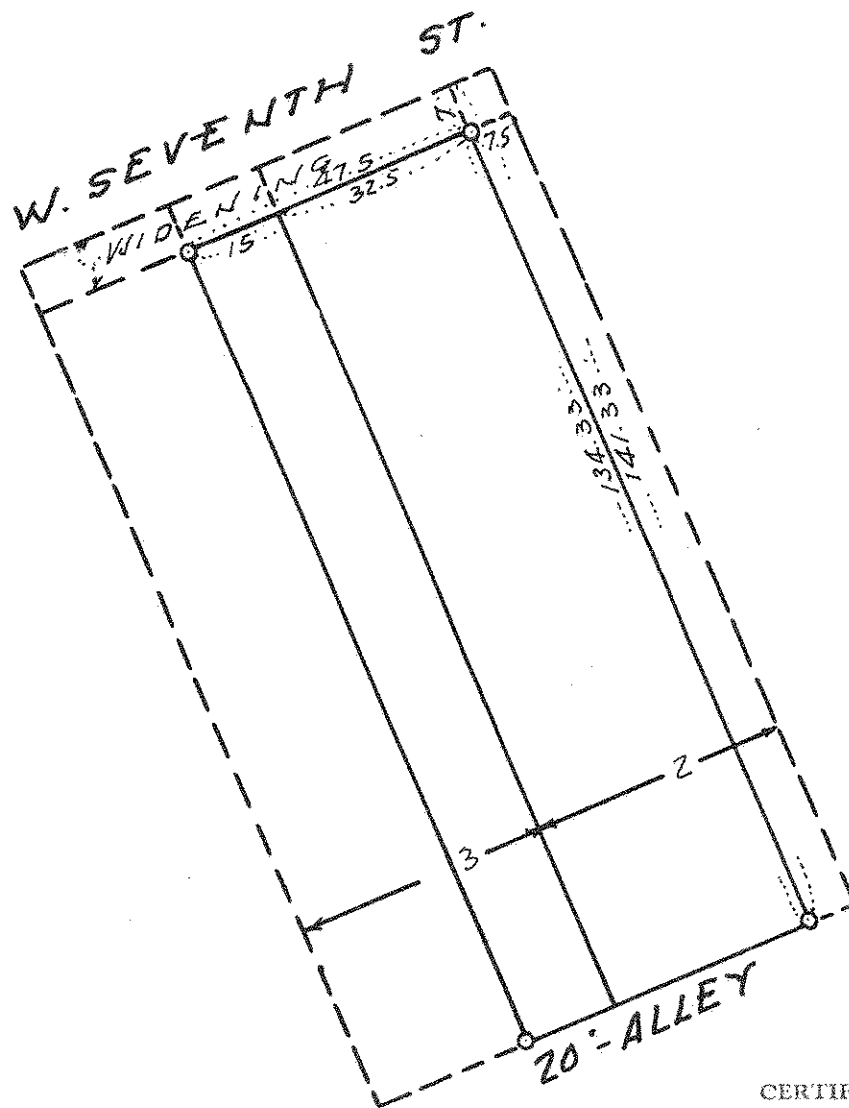

CERTIFICATE OF SURVEY

I hereby certify that on 9-21 19 54

I surveyed the property described above and that the above
plat is a correct representation of said survey.

T. J. Welch