

TELEPHONE TOWER 0640


PLAT OF SURVEY

OF PROPERTY OF _____

DESCRIBED AS FOLLOWS Lot 1, and the Northeastly 7.5 feet of Lot 2, Block 4,
Kentucky Terrace

SCALE: 1 INCH 30 FEET
O DENOTES IRON

T. J. WELCH, REGISTERED SURVEYOR
738 SURREY AVENUE, ST. PAUL 6, MINN.

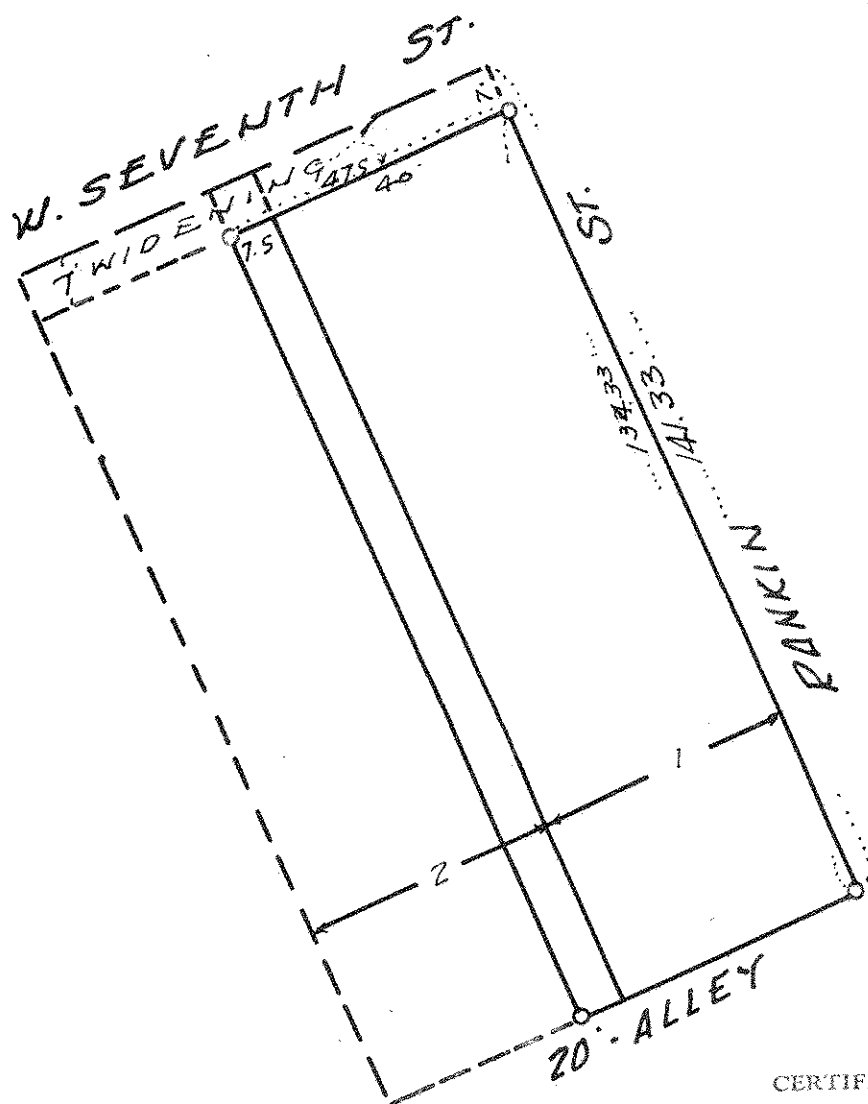

CERTIFICATE OF SURVEY

I hereby certify that on 9-21 1954
I surveyed the property described above and that the above
plat is a correct representation of said survey.

T. J. Welch