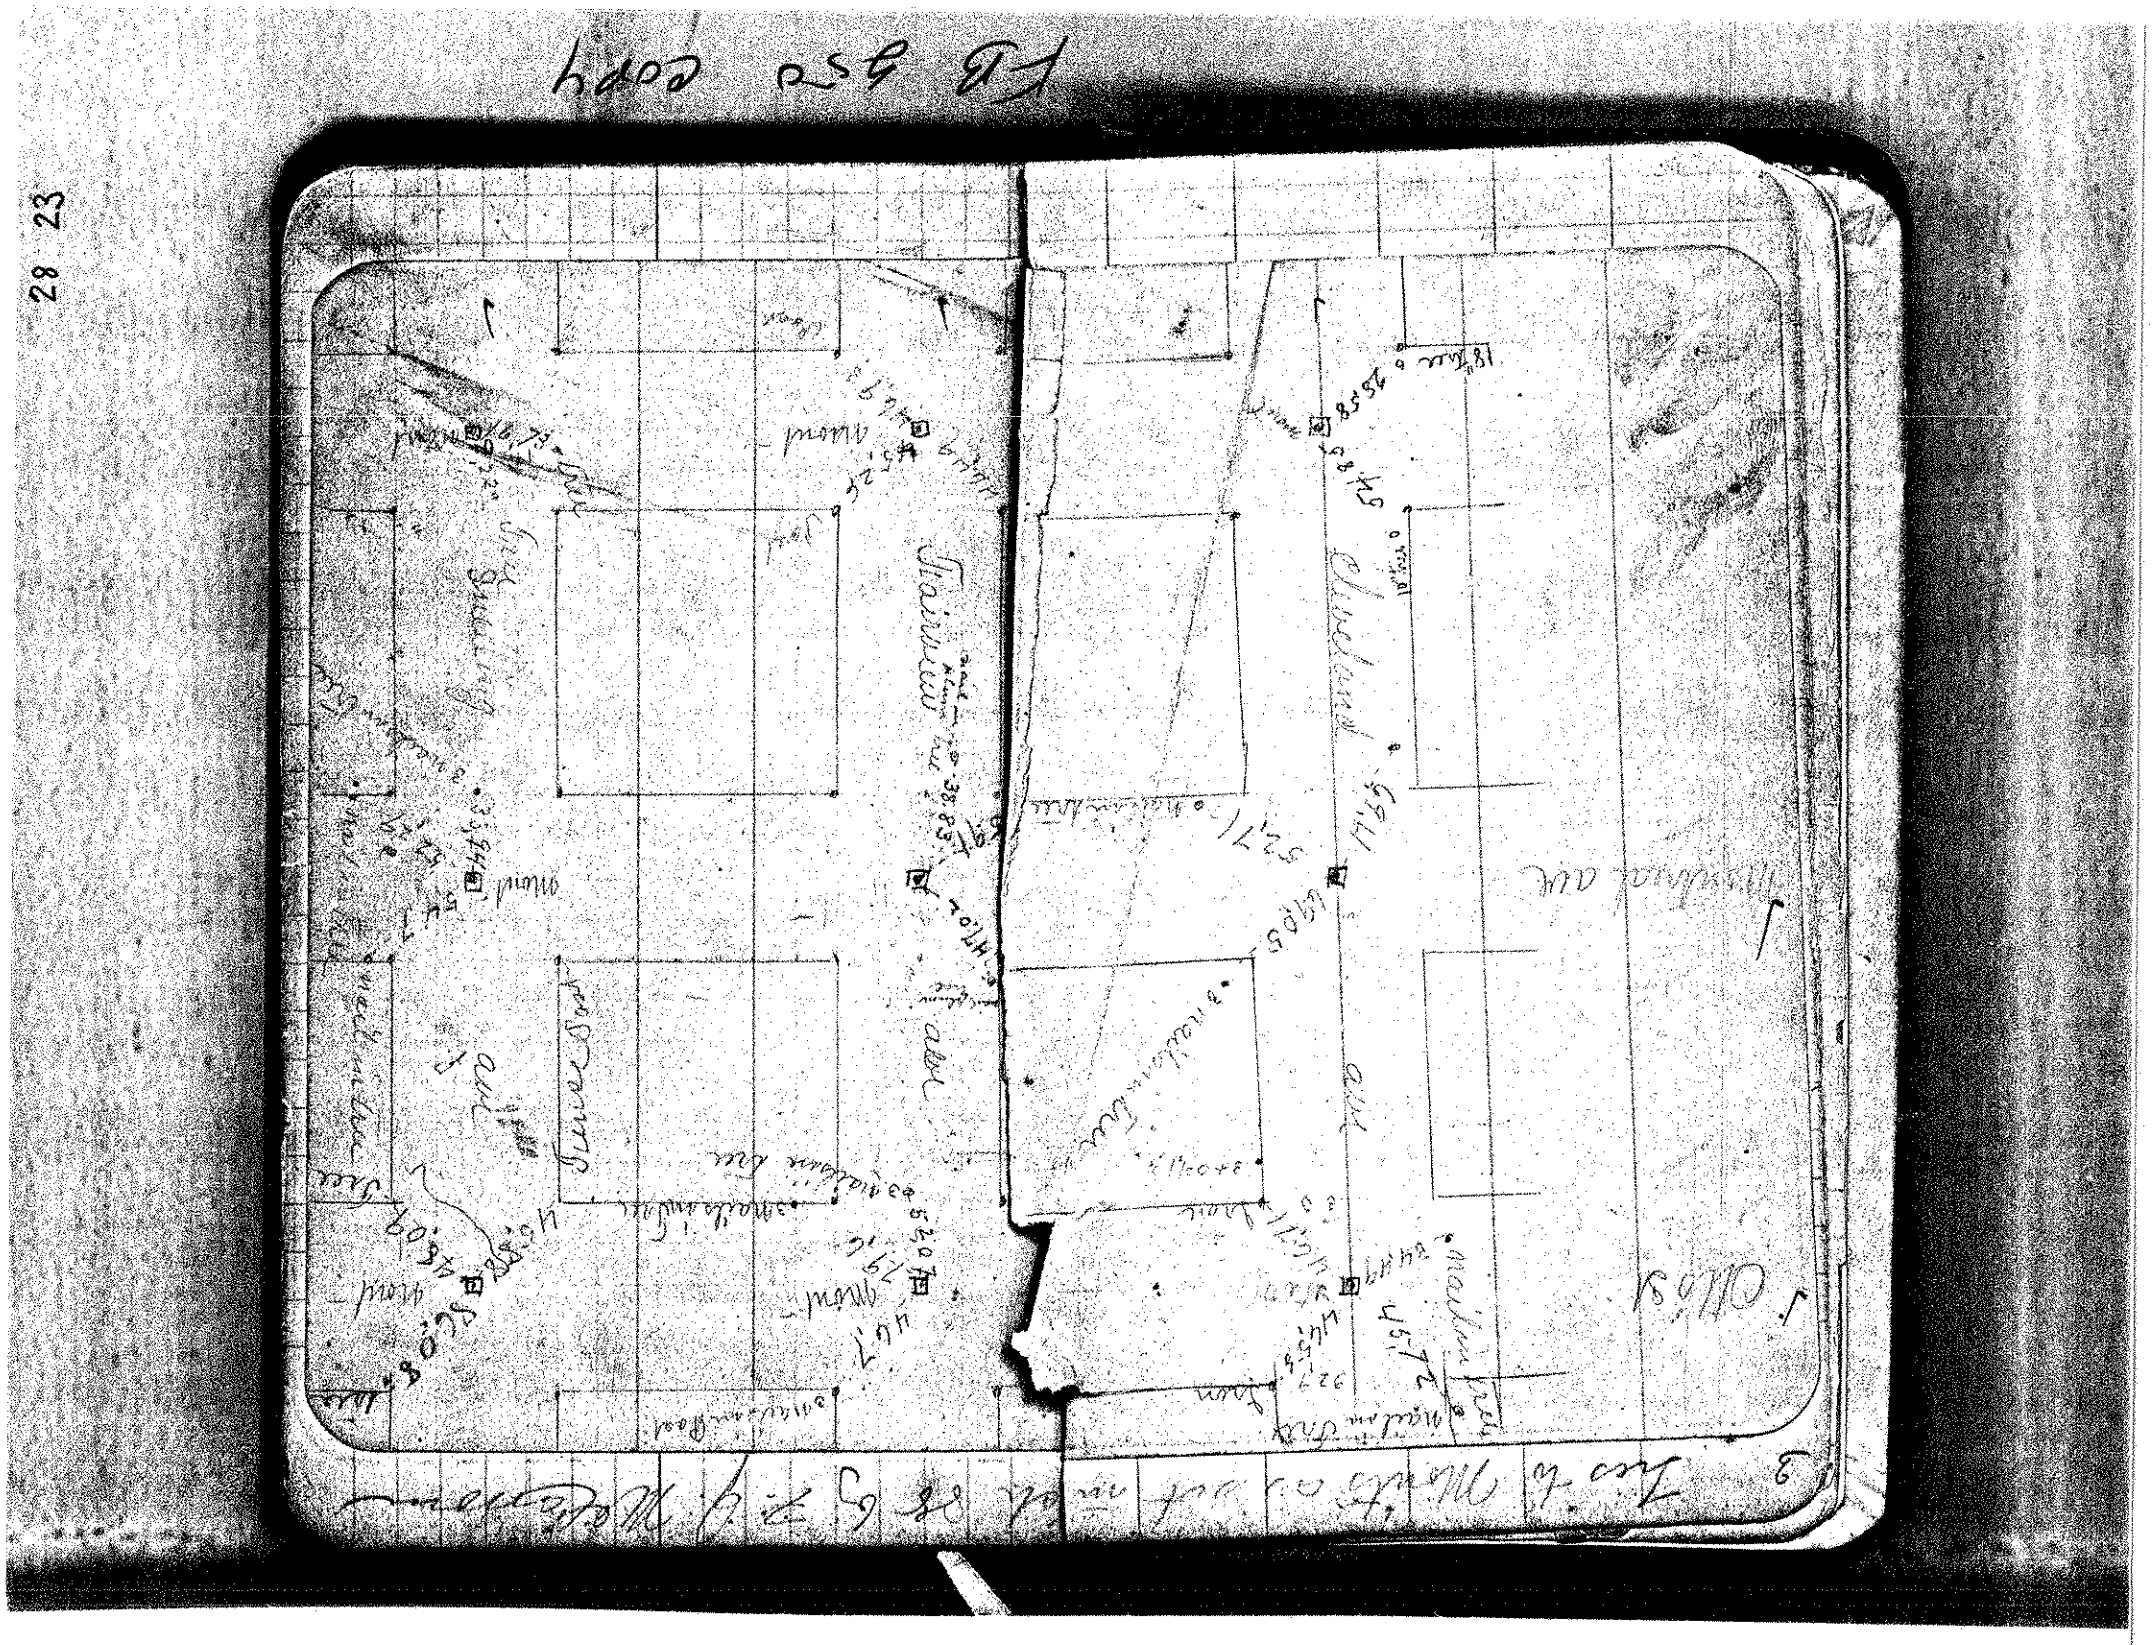28 23