

BILL
OR
MIKE'S
COPY
10-3-94

CERTIFICATE OF LOCATION OF GOVERNMENT CORNER

1/4 Corner of Section 27, Township 29, Range 23, _____ P.M.

STATE OF MINNESOTA, County of RAMSEY


At the corner location shown on the sketch:

On AUG. 24, 1994 found a CAST IRON MONT. 0.15 BELOW GRADE
DATE

left monument as found, lowered monument, removed monument (explain)

On _____ placed a _____
DATE

SKETCH OF REFERENCE TIES

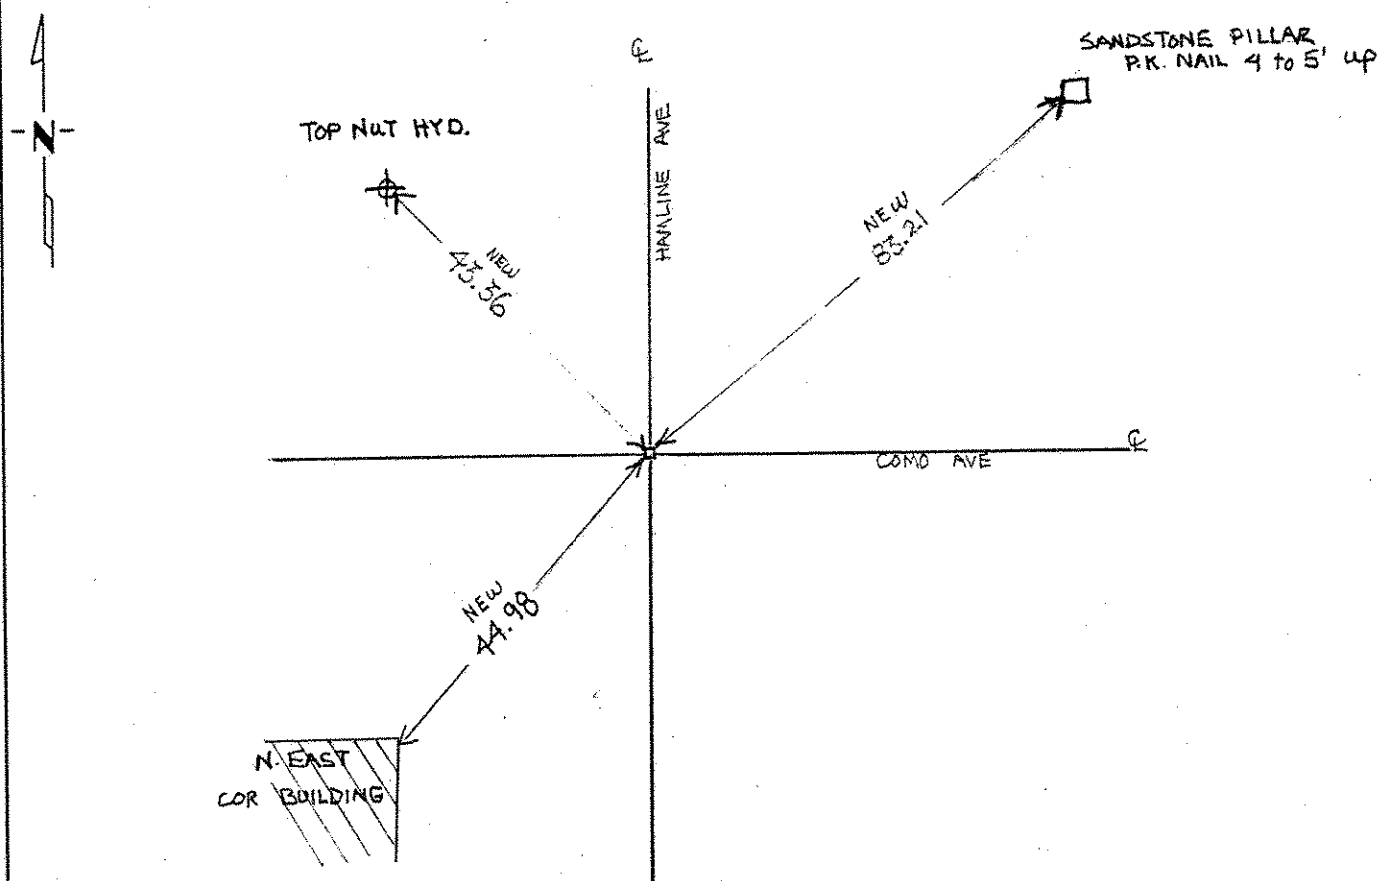

SKETCH BY: M. WASSMAN ON OCT. 3, 1994 FIELD TIES BY: M. ENGEL & B. MARKGRAF 8/24/94

Statement of evidence relative to this corner location is on back of page.

I hereby certify that this document and the data contained herein was prepared by me or under my direct supervision.

SIGNATURE DATE

Registration No. _____

- Land Surveyor, Professional Engineer
- County Surveyor, County Engineer

OFFICE OF THE COUNTY RECORDER

County of _____

I hereby certify that this document was filed in the Co. Recorders office at _____ M. on the _____ day of _____ A.D., 19 _____

County Recorder _____

By _____, Deputy

DOCUMENT NO. _____