(CITY) Index No. 235

CERTIFICATE OF LOCATION OF GOVERNMENT CORNER

1/4 Corner of Section 16, Township 28, Range 23, ____ P.M.

STATE OF MINNESOTA, County of RAMSEY

At the corner location shown on the sketch:

☒ On SEPT. 30, 1994 (DATE) found a CAST IRON MONT. AT GRADE

☒ left monument as found, ☐ lowered monument, ☐ removed monument (explain)

☐ On ____ (DATE) placed a ____

SKETCH OF REFERENCE TIES

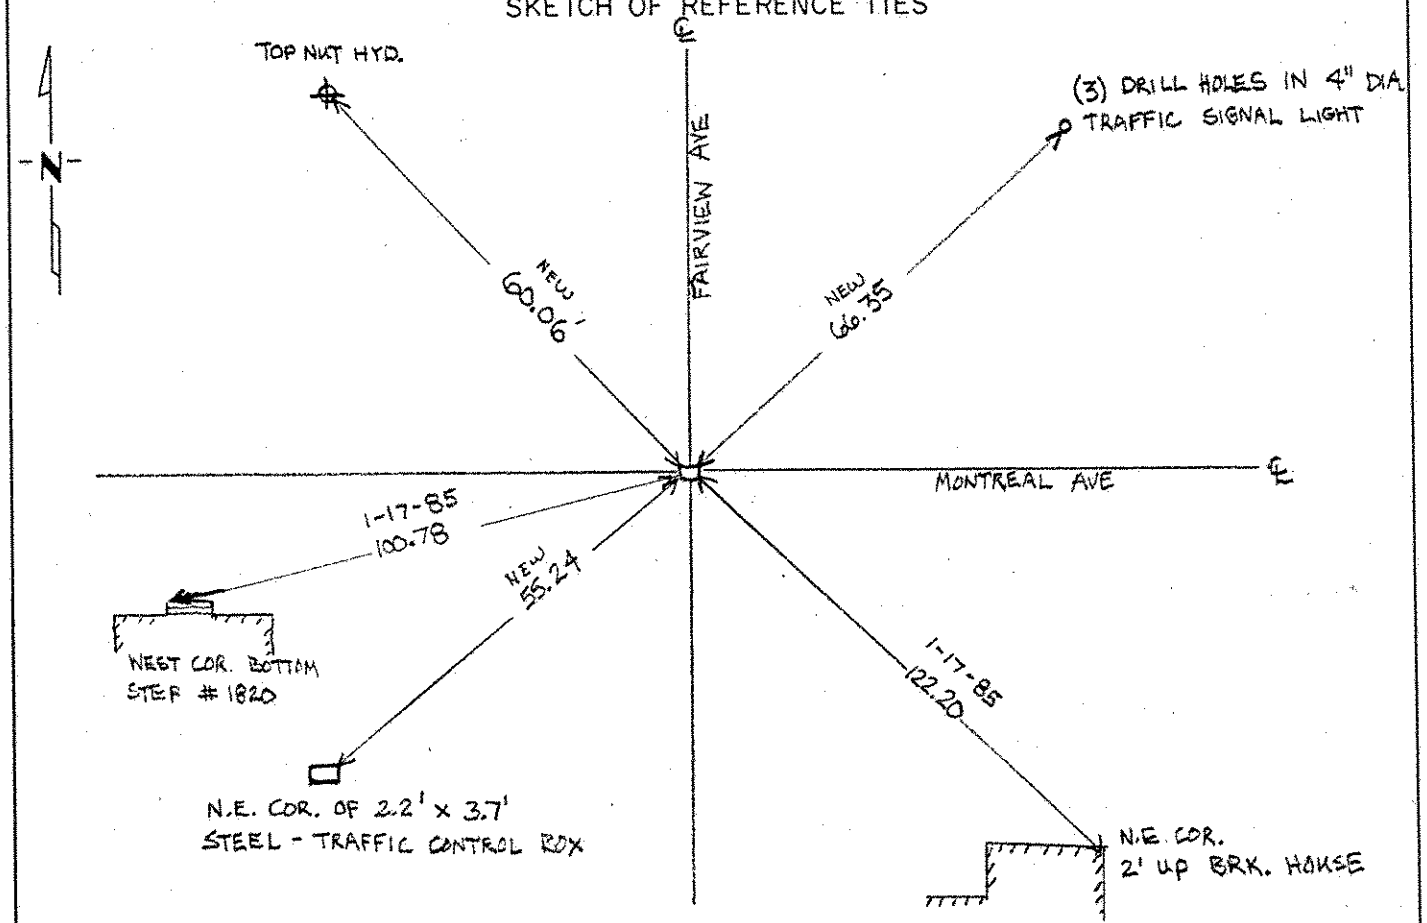

SKETCH BY: M. WASSMAN ON OCT. 3, 1994 FIELD TIES BY: D. NELSON, M.W. & BSM 9-30-94

Statement of evidence relative to this corner location is on back of page.

I hereby certify that this document and the data contained herein was prepared by me or under my direct supervision.

____ SIGNATURE ____ DATE

Registration No. ____

☐ Land Surveyor, ☐ Professional Engineer

☐ County Surveyor, ☐ County Engineer

OFFICE OF THE COUNTY RECORDER

County of ____

I hereby certify that this document was filed in the Co. Recorders office at ____ .M. on the ____ day of ____ A.D., 19 ____

County Recorder ____

By ____, Deputy

DOCUMENT NO. ____

Mn/DOT 2105 (4-77)