


FB 1362

7/8/54
E.T.
R.J.

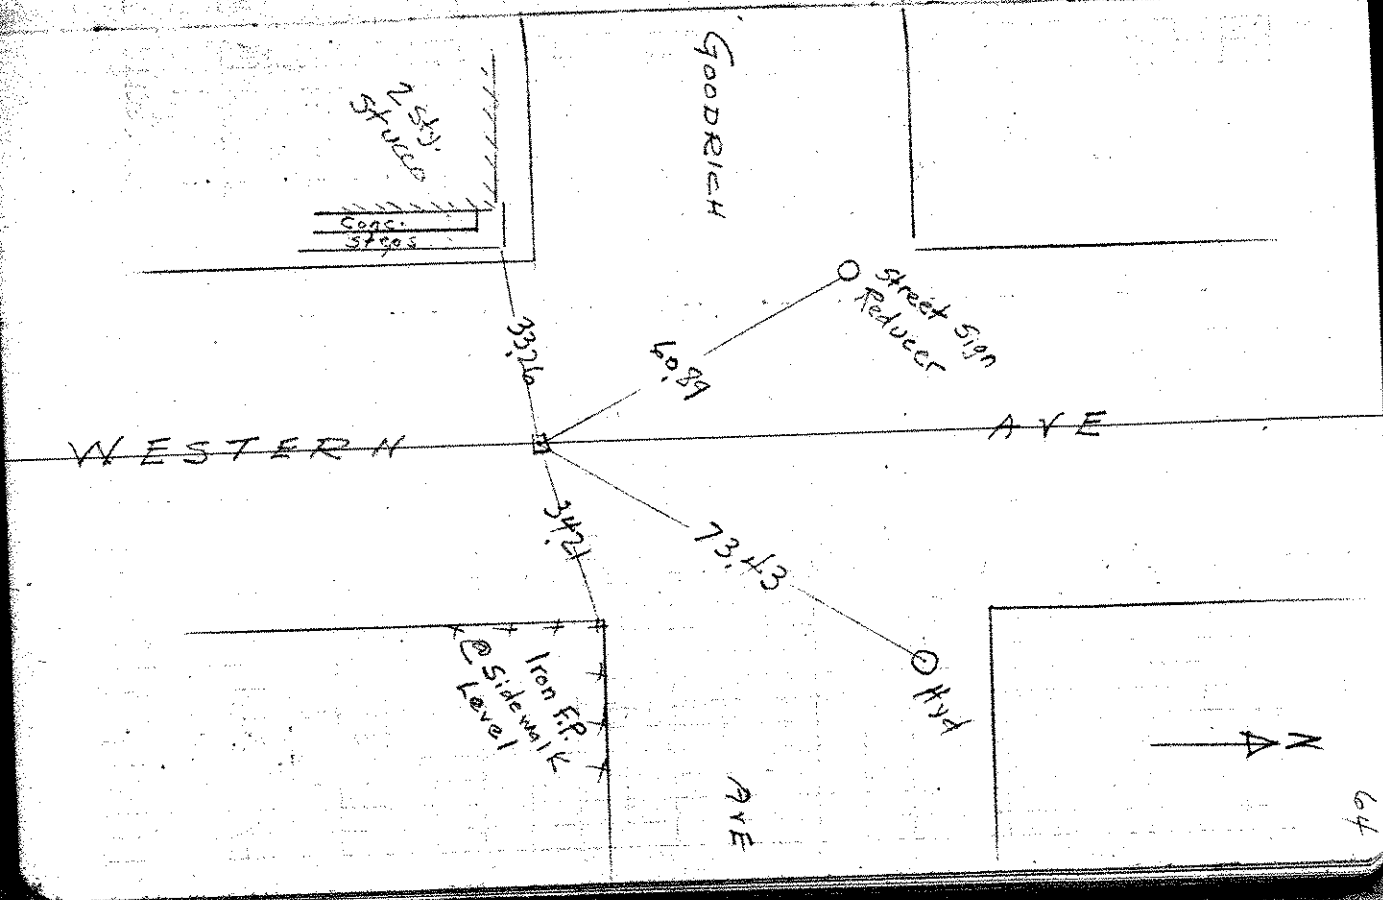

64