

1 28 23

LOTS 1 & 2 BLOCK 3.

BERNHEIMER'S ADD.

JOHN B. IRVINE. SURVEYOR.

ROOM 406 GLOBE BLD'G.


SCALE 1 IN. = 20 FT.

ST PAUL. MINN.

BANFILL ST. APRIL 3-06.

SPIKE

SPIKE

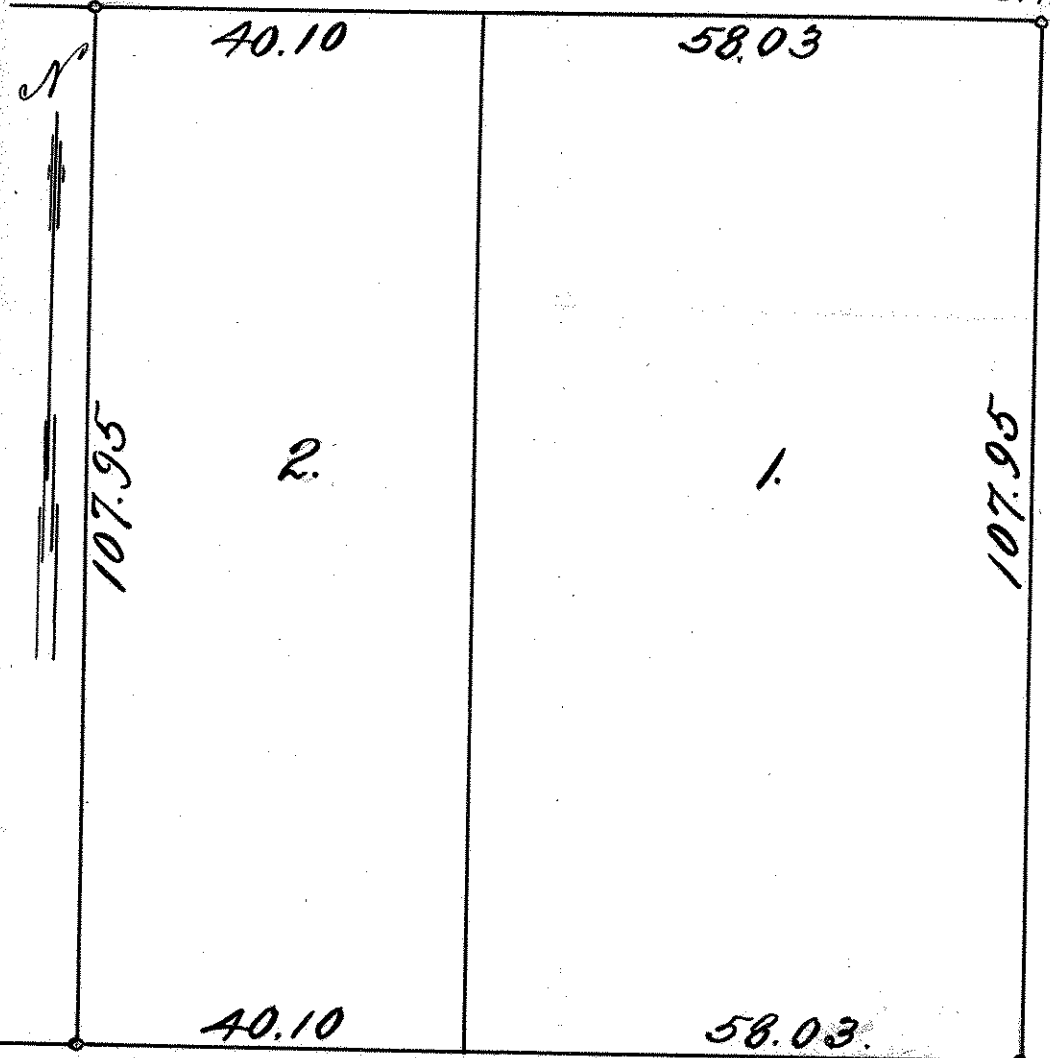

N

107.95

40.10

2.

40.10

SPIKE

58.03

1.

58.03.

SPIKE.

107.95

SMITH AVE.

ALLEY 20.