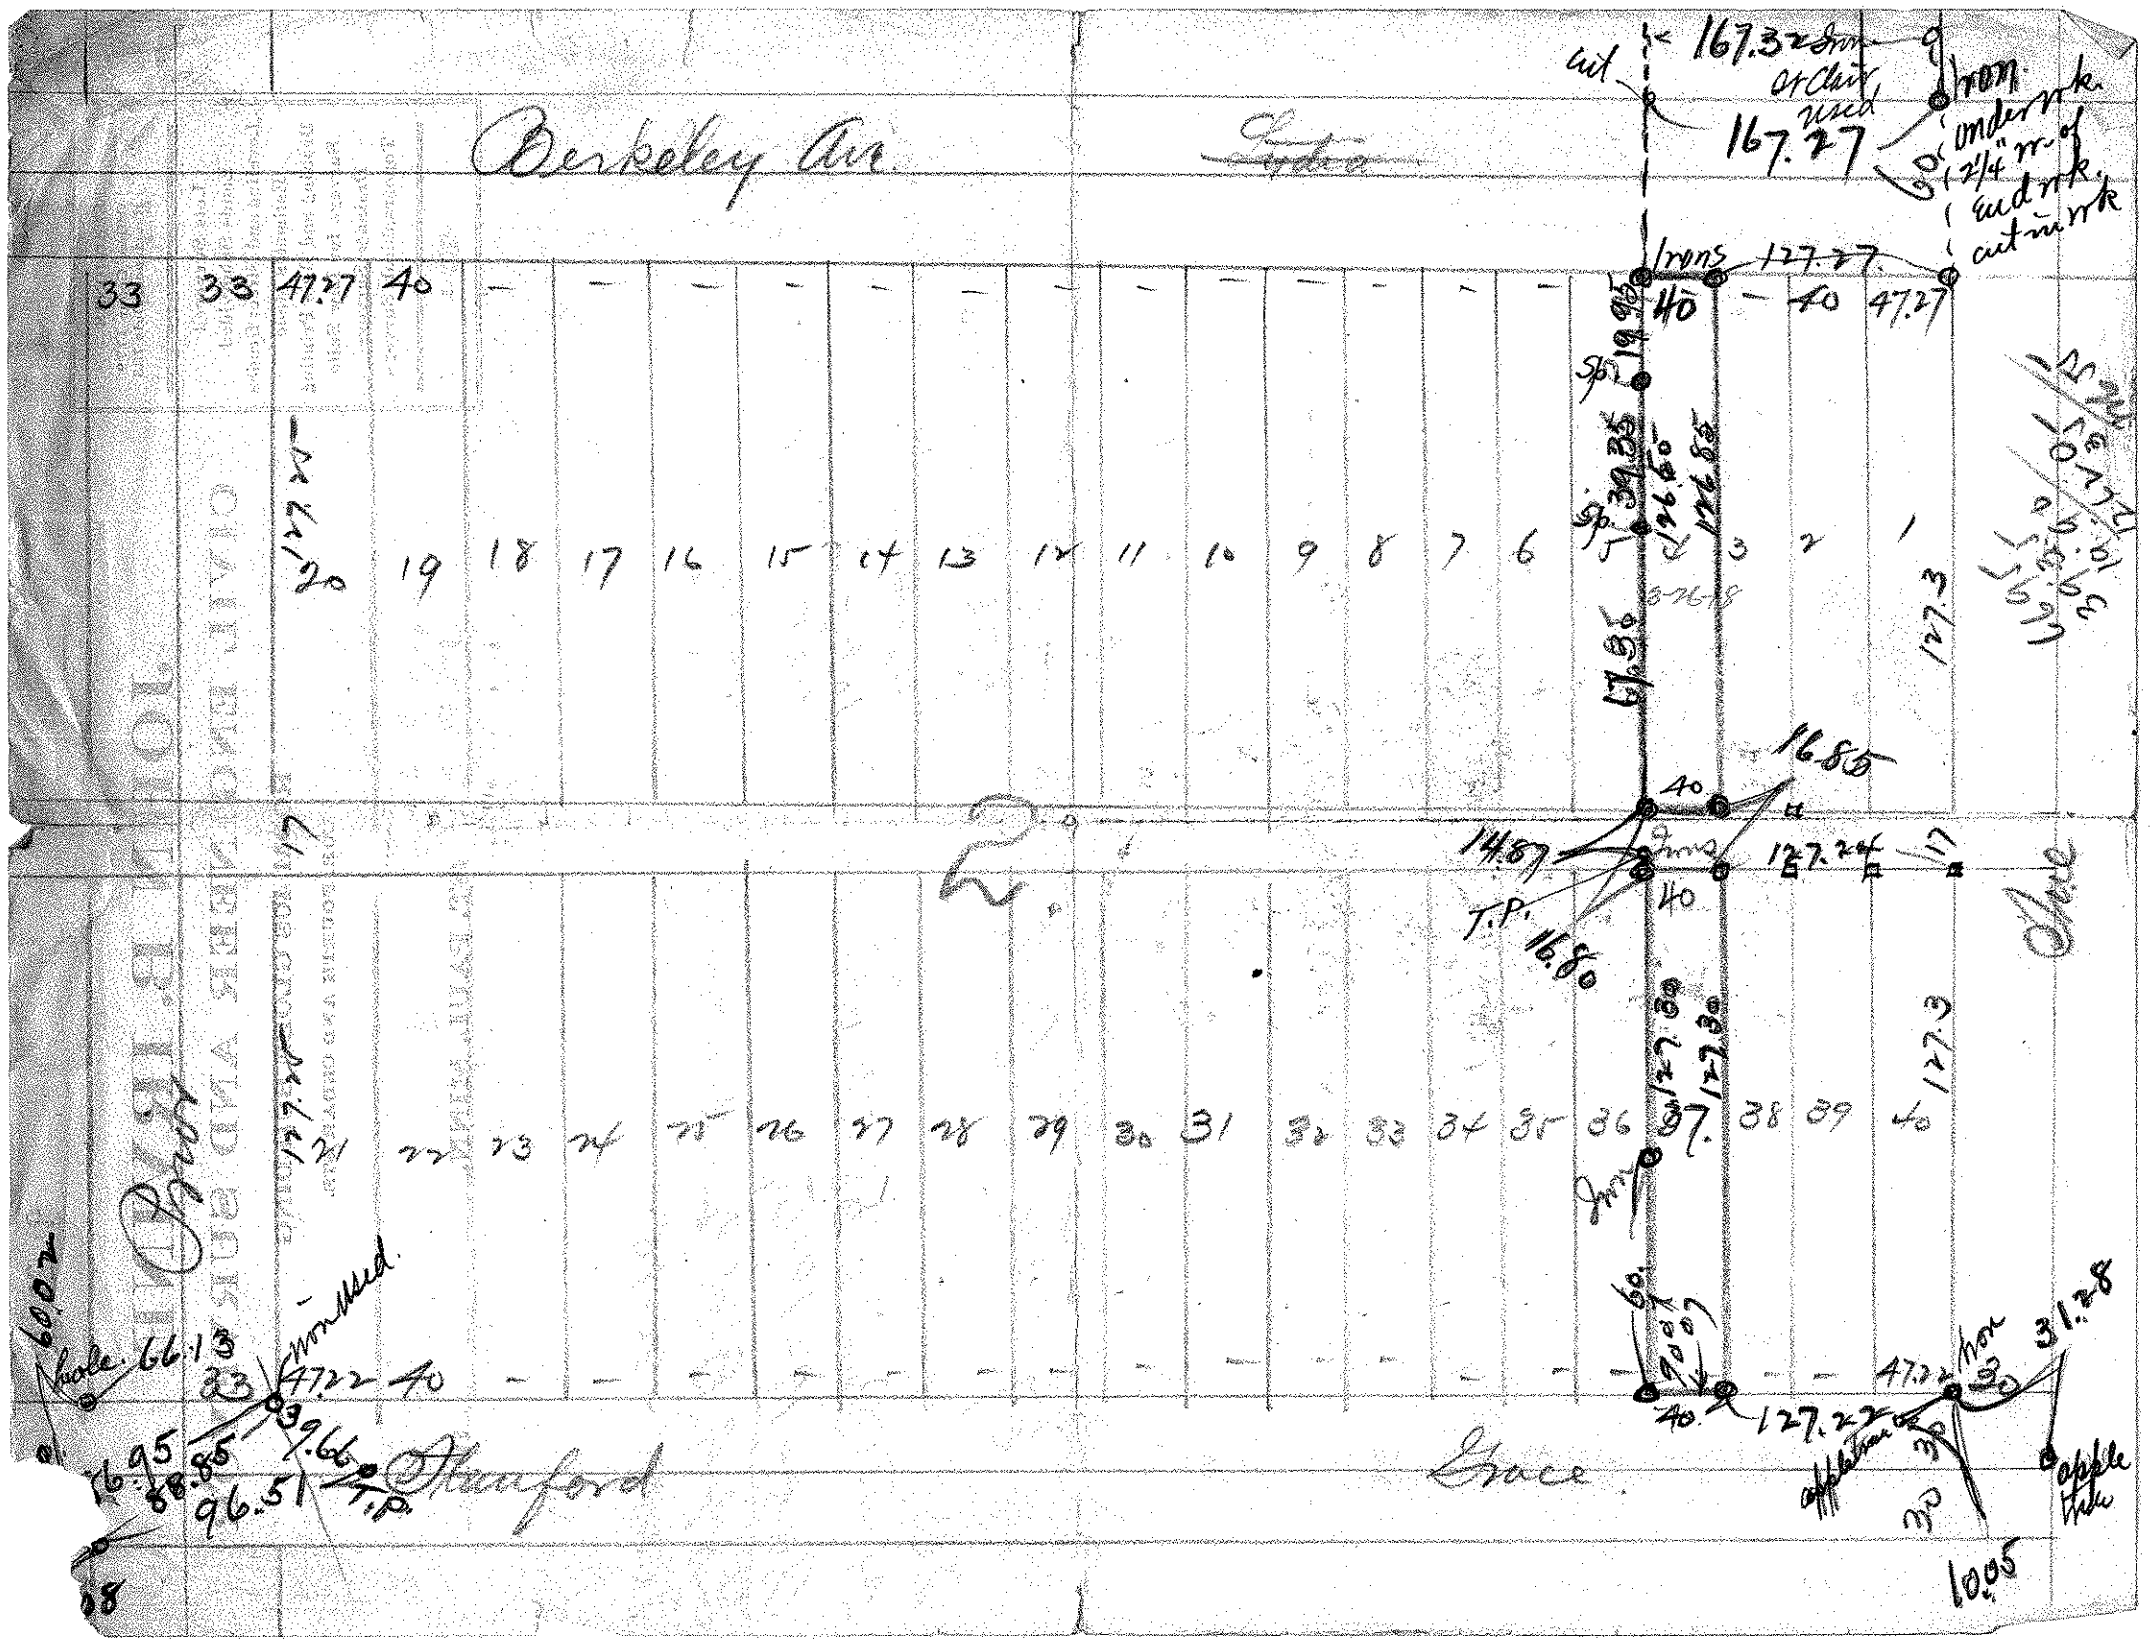

Berkeley Ave
Lydia
167.32 Iron
cut
167.27
Iron
under wk.
2 1/4" w. of
end wk.
cut in wk
Irons
127.27
33
33
47.27
40
40
47.27
19.95
39.35
126.60
126.85
127.3
16.85
14.87
127.24
T.P.
16.80
127.30
127.30
127.3
Iron
Grace
Stanford
Iron
60.02
hole
66.13
33
47.22
40
39.66
T.P.
96.51
88.85
16.95
Grace
127.22
47.22
Iron
31.28
apple tree
10.05