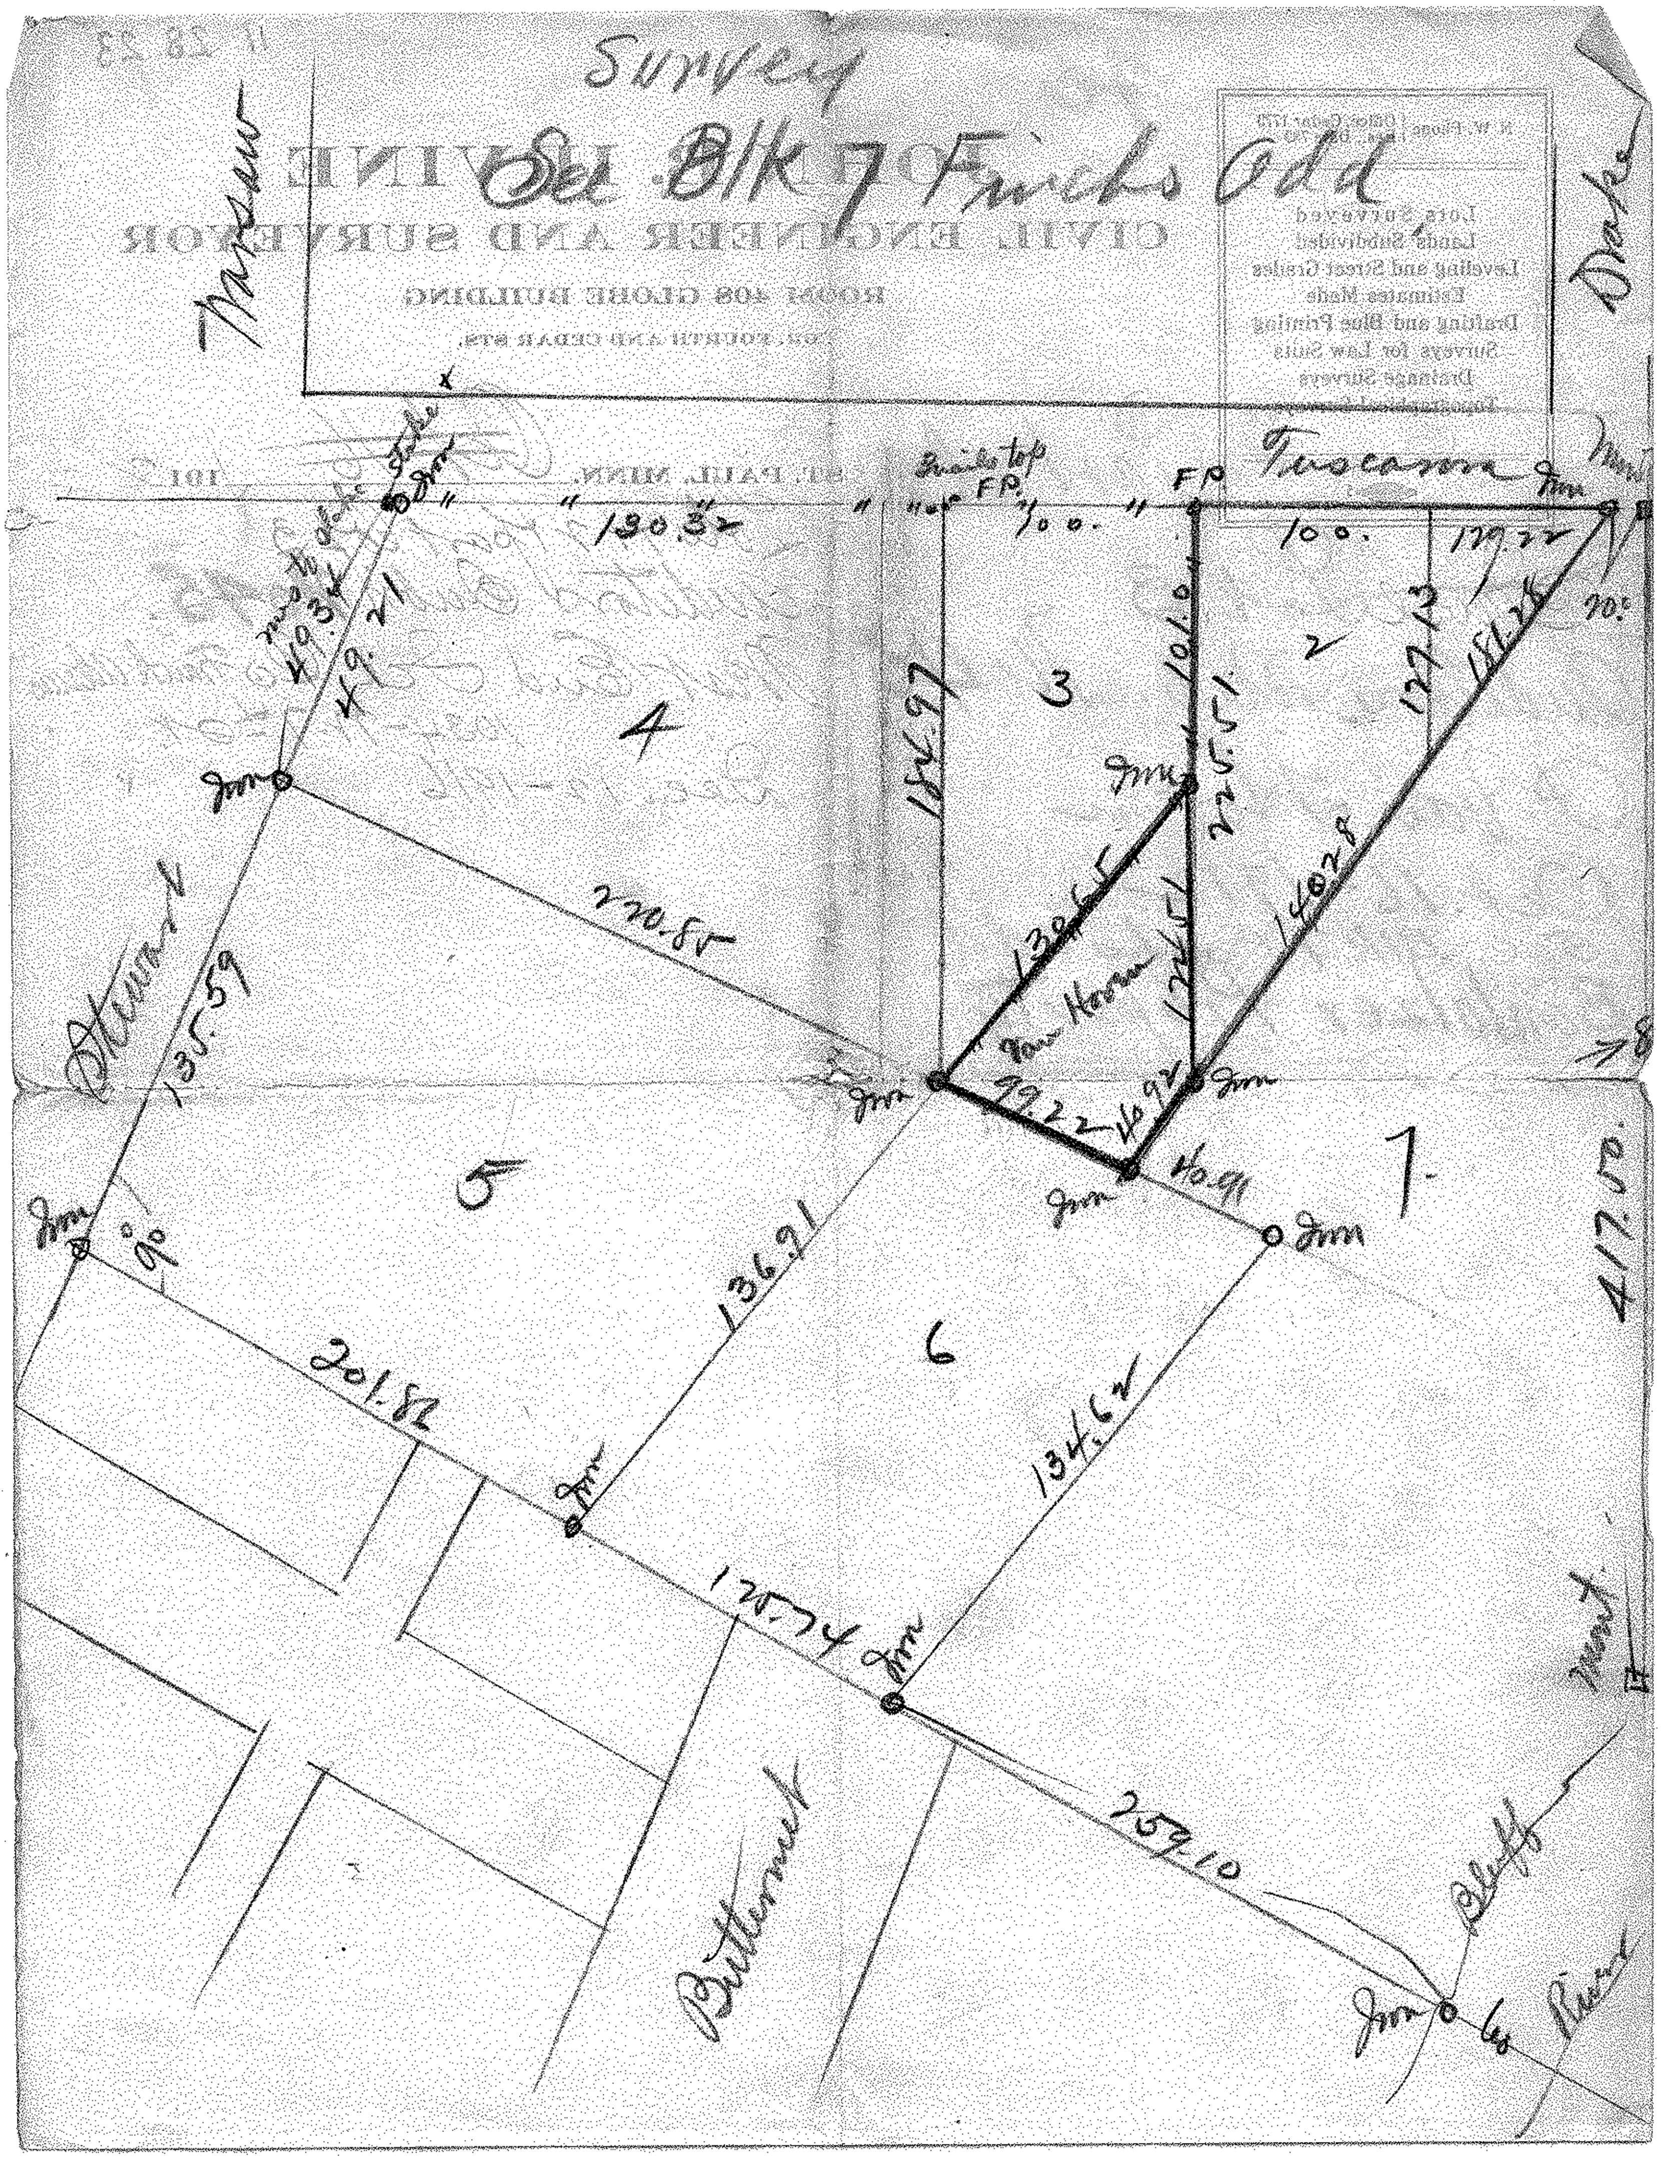
Survey
Blk 7 Finchs Add
Tuscarora
Drake
Stewart
Butternut
Bluff
River
190.32
100.
100.
179.22
49.21
135.59
220.85
184.97
101.0
225.51
127.13
181.28
140.28
99.22
40.92
40.91
136.91
134.62
201.82
175.74
259.10
417.50
1
2
3
4
5
6
7