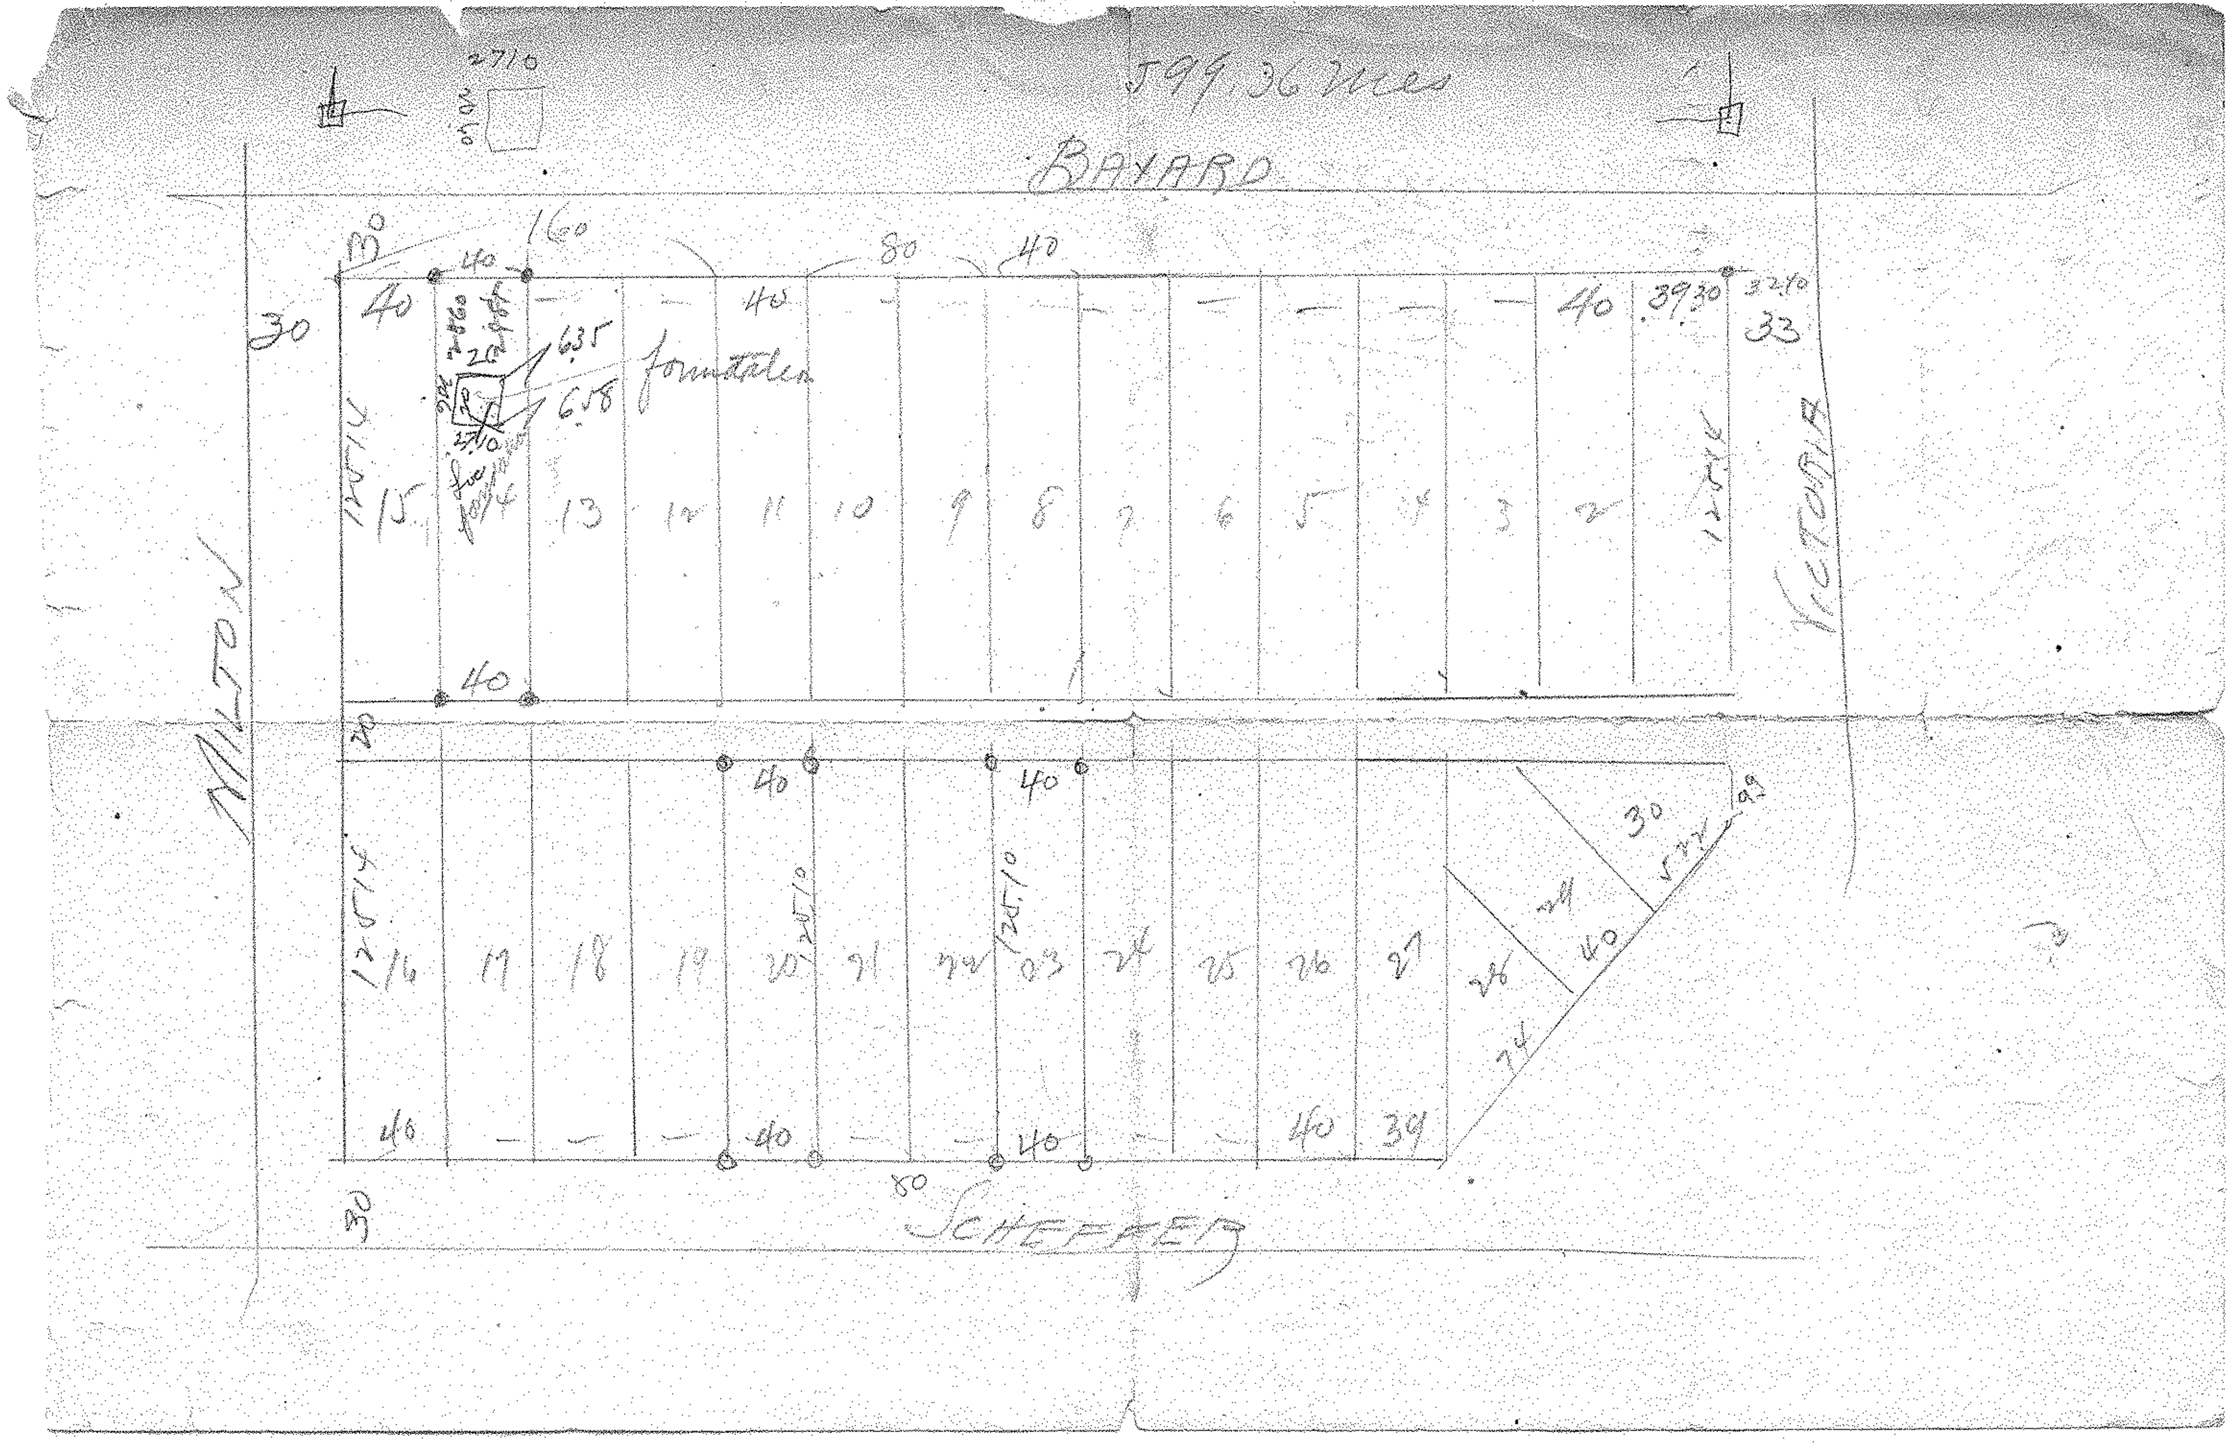
BAYARD
MILTON
VICTORIA
SCHEFFER