


Lot 12 Blk 72 BANNING & OLIVER'S ADD.

20' = 1" • = stake

JUNE 29TH 1904 L.I. Dearborn.

CHIPPENAW AVE.

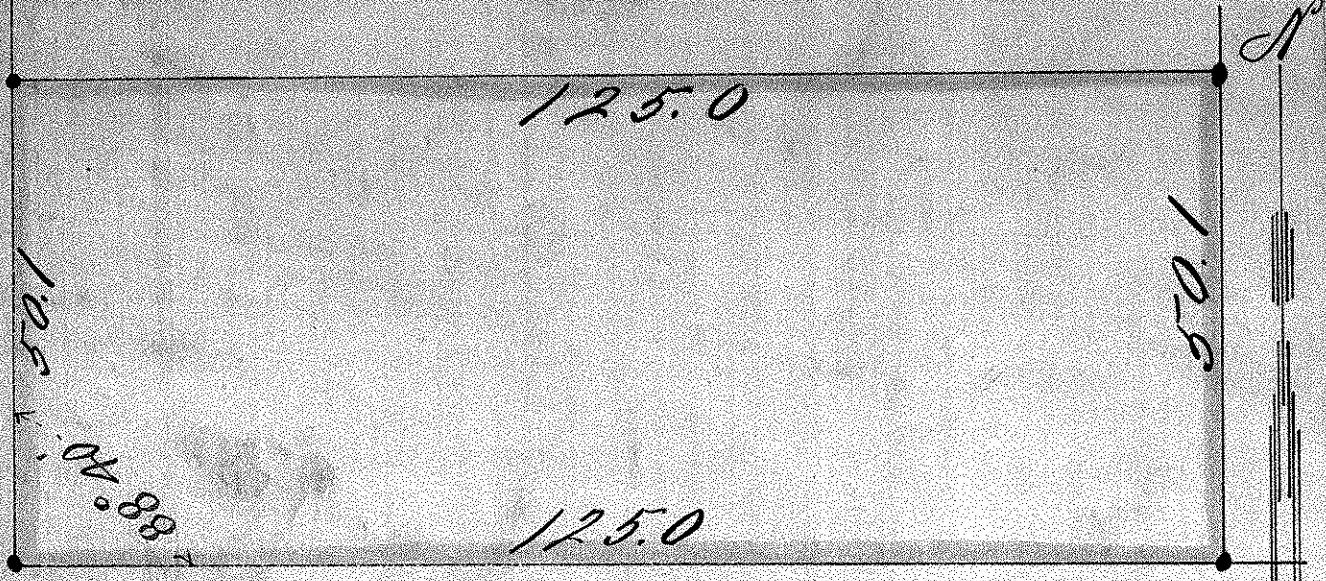

MORTON

ST.