


LOTS 10, 11 & 12 BLOCK 78 BANNING & OLIVER'S ADD.

JOHN B. IRVINE, SURVEYOR.
408 GLOBE BLDG.
ST. PAUL, MINN.
MAY 4-1912.
SCALE 20 ft. per inch.

CHIPPEWA AVE.

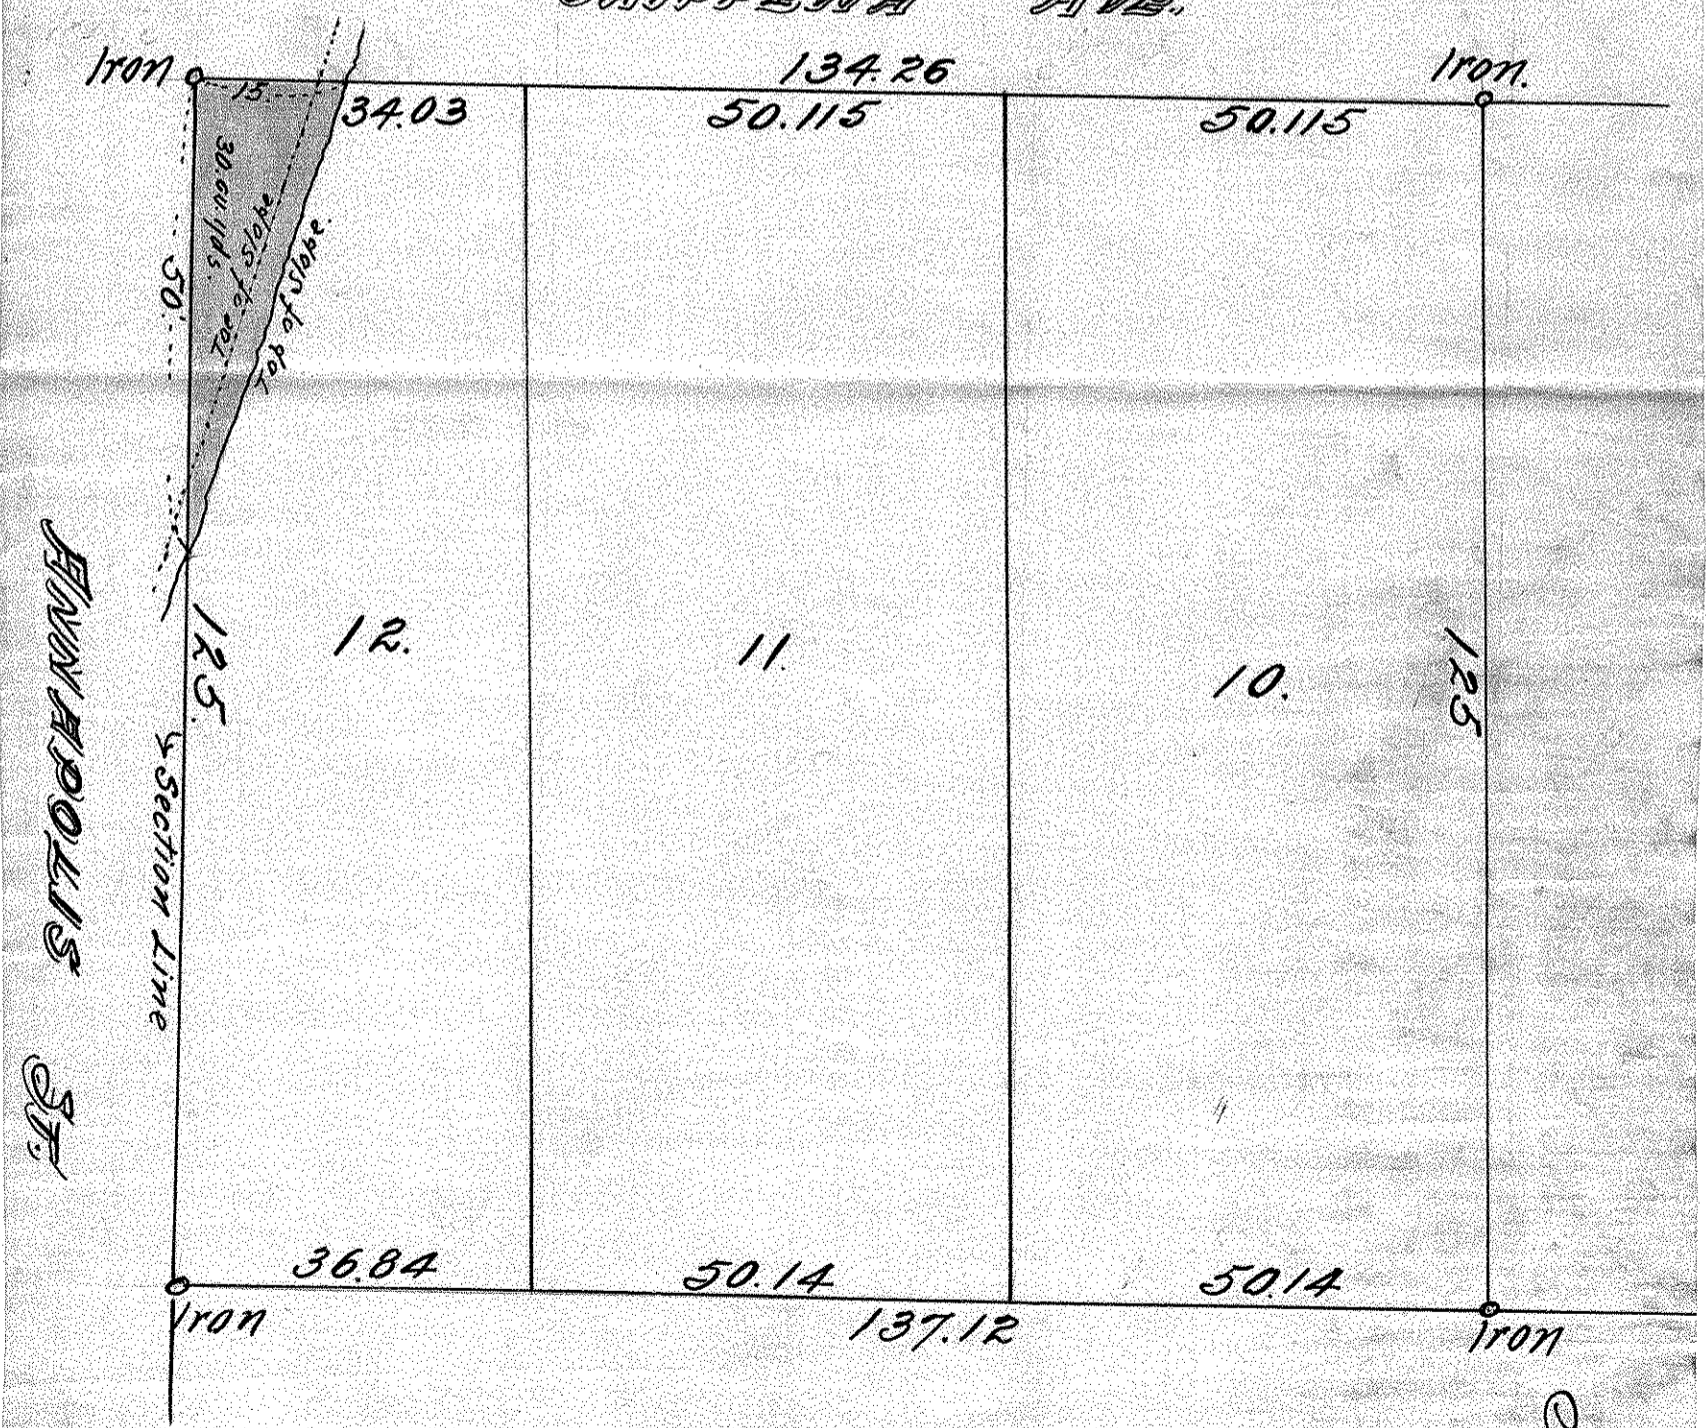

J