


LOT 6. BLOCK 72.
BANNING & OLIVER'S
ADDITION.

JOHN B. IRVINE, SURVEYOR.
408 GLOBE BLD'G.
ST. PAUL, MINN.
APRIL 19-1911.
SCALE 20 ft. per inch.

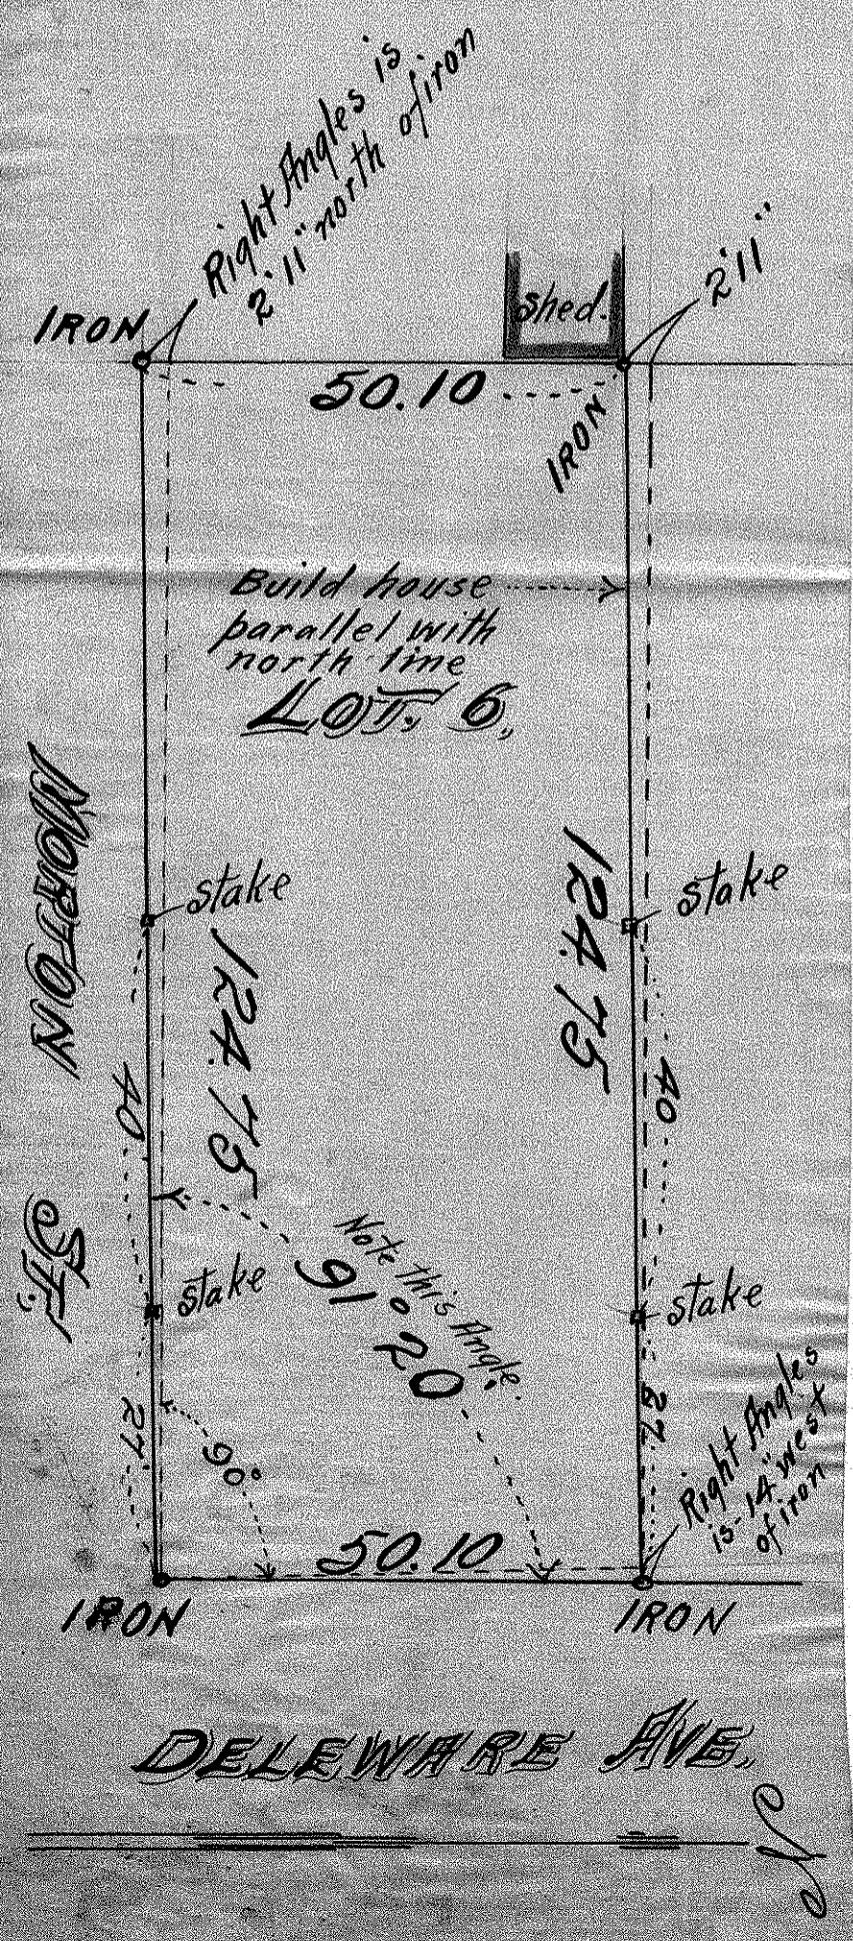

DELEWARE AVE.