


Sydney

Spinal

7/9

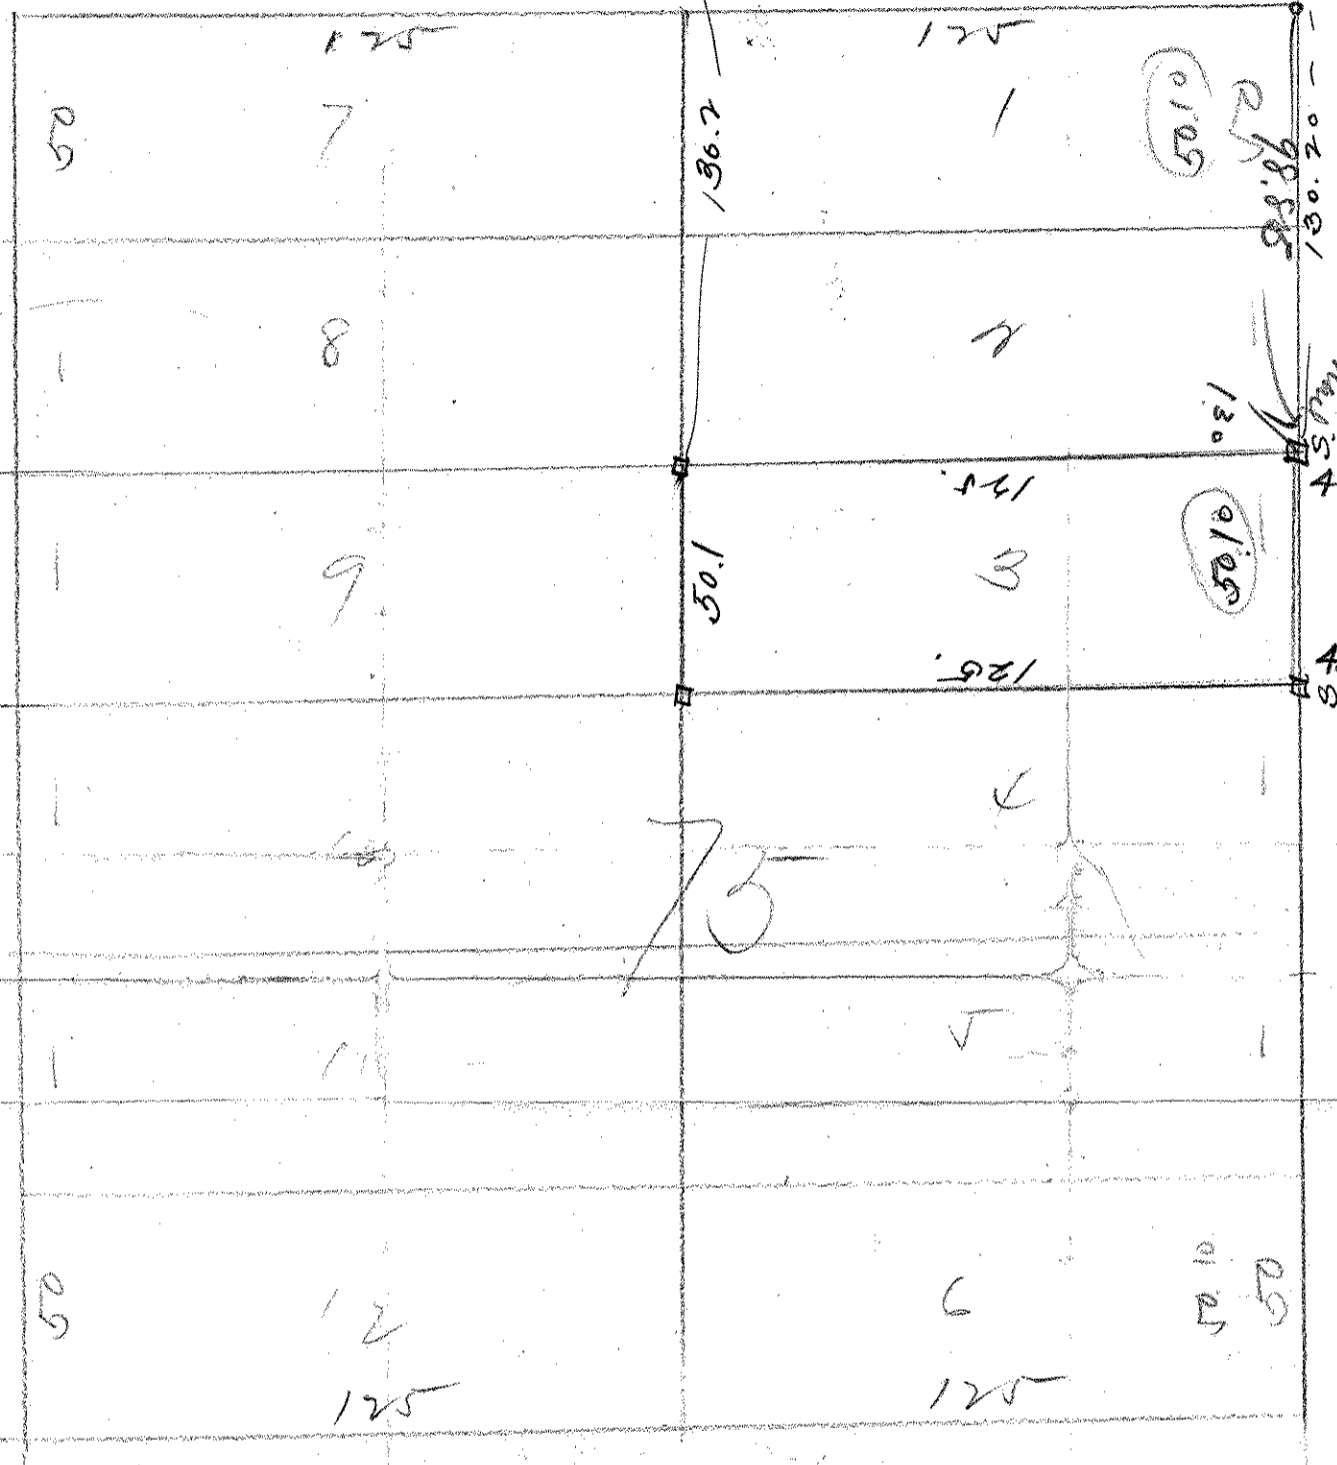

140304  
 1042.75  
 1648260 29  
 389.73

16.53

16.59

43.36

16.70

16.75

16.81

1042.75

30.10

Belmont  
 16.64  
 16.59  
 16.70

60

200

210

60

30

84.24 - 16" tree

16.81  
 16.48  
 360 / 3300 (96)  
 3240  
 60.27