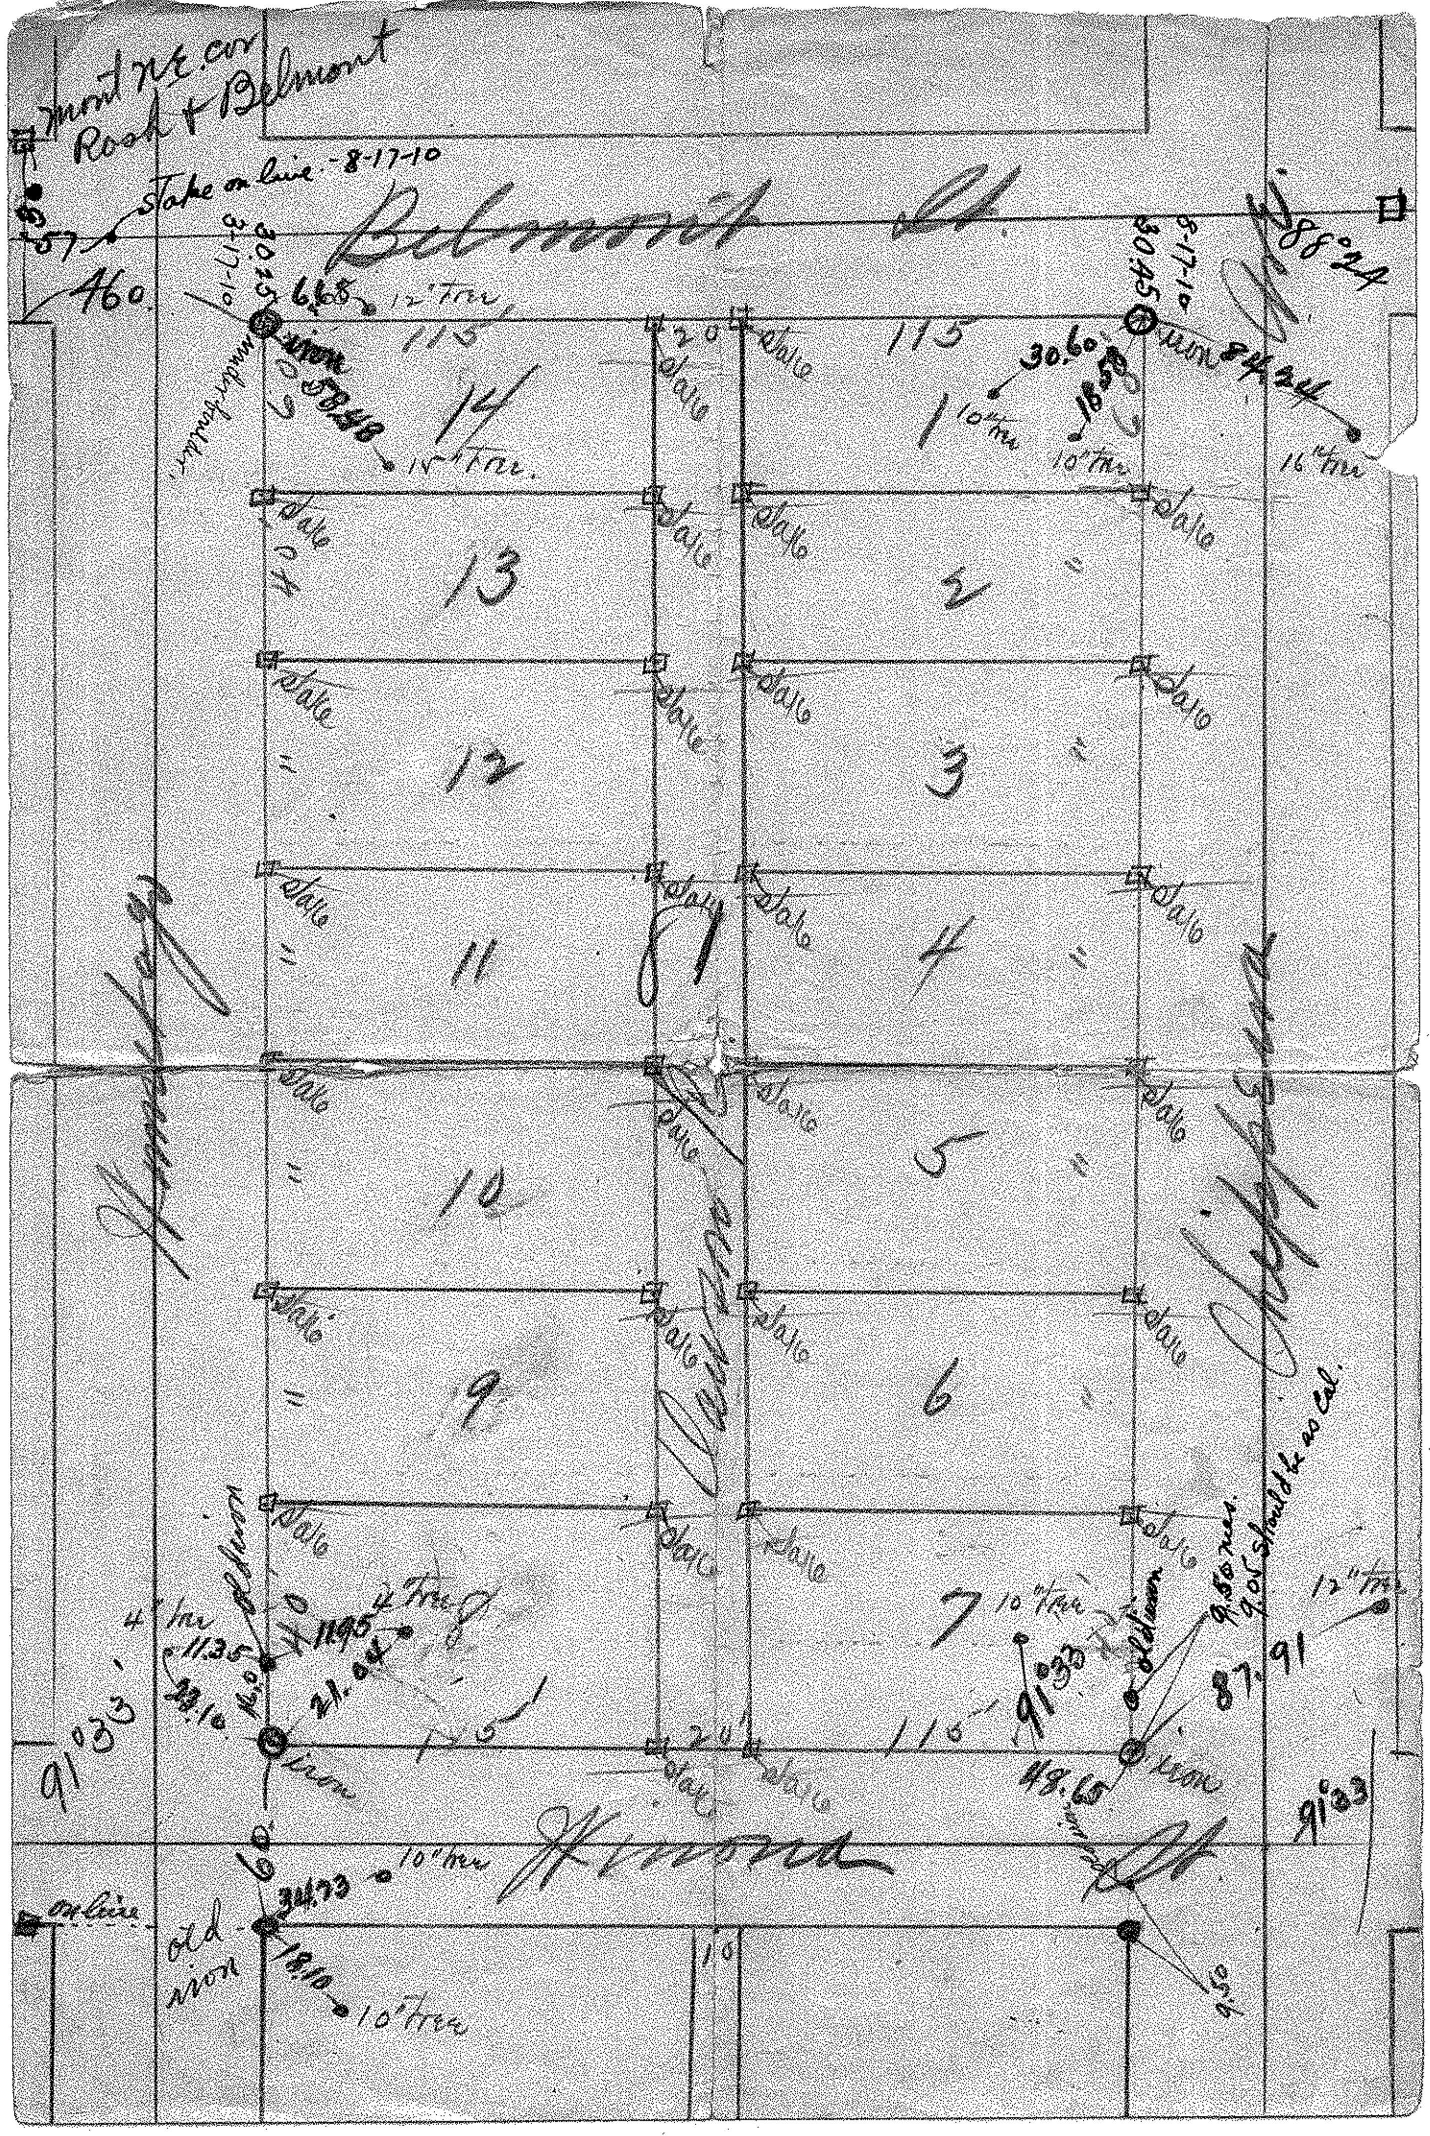

Mont NE cor Rosh + Belmont
Stake on line - 8-17-10
Belmont St.
460.
3-17-10
30.25
6.68
12" Tree
115
20
iron
53.48
15" Tree
under boulder
60
40
8-17-10
30.45
30.60
18.58
iron 84.24
10" tree
16" tree
88°24
14
13
12
11
10
9
8
1
2
3
4
5
6
7
stake
18
4" tree
11.35
23.10
11.95
21.04
4" tree
old iron
91°33'
10" tree
91°33'
9.50 meas.
9.05 should be as cal.
12" tree
87.91
48.65
iron
91°33
Winona St.
10" tree
34.73
on line
old iron
18.10
10" Tree
10
9.50