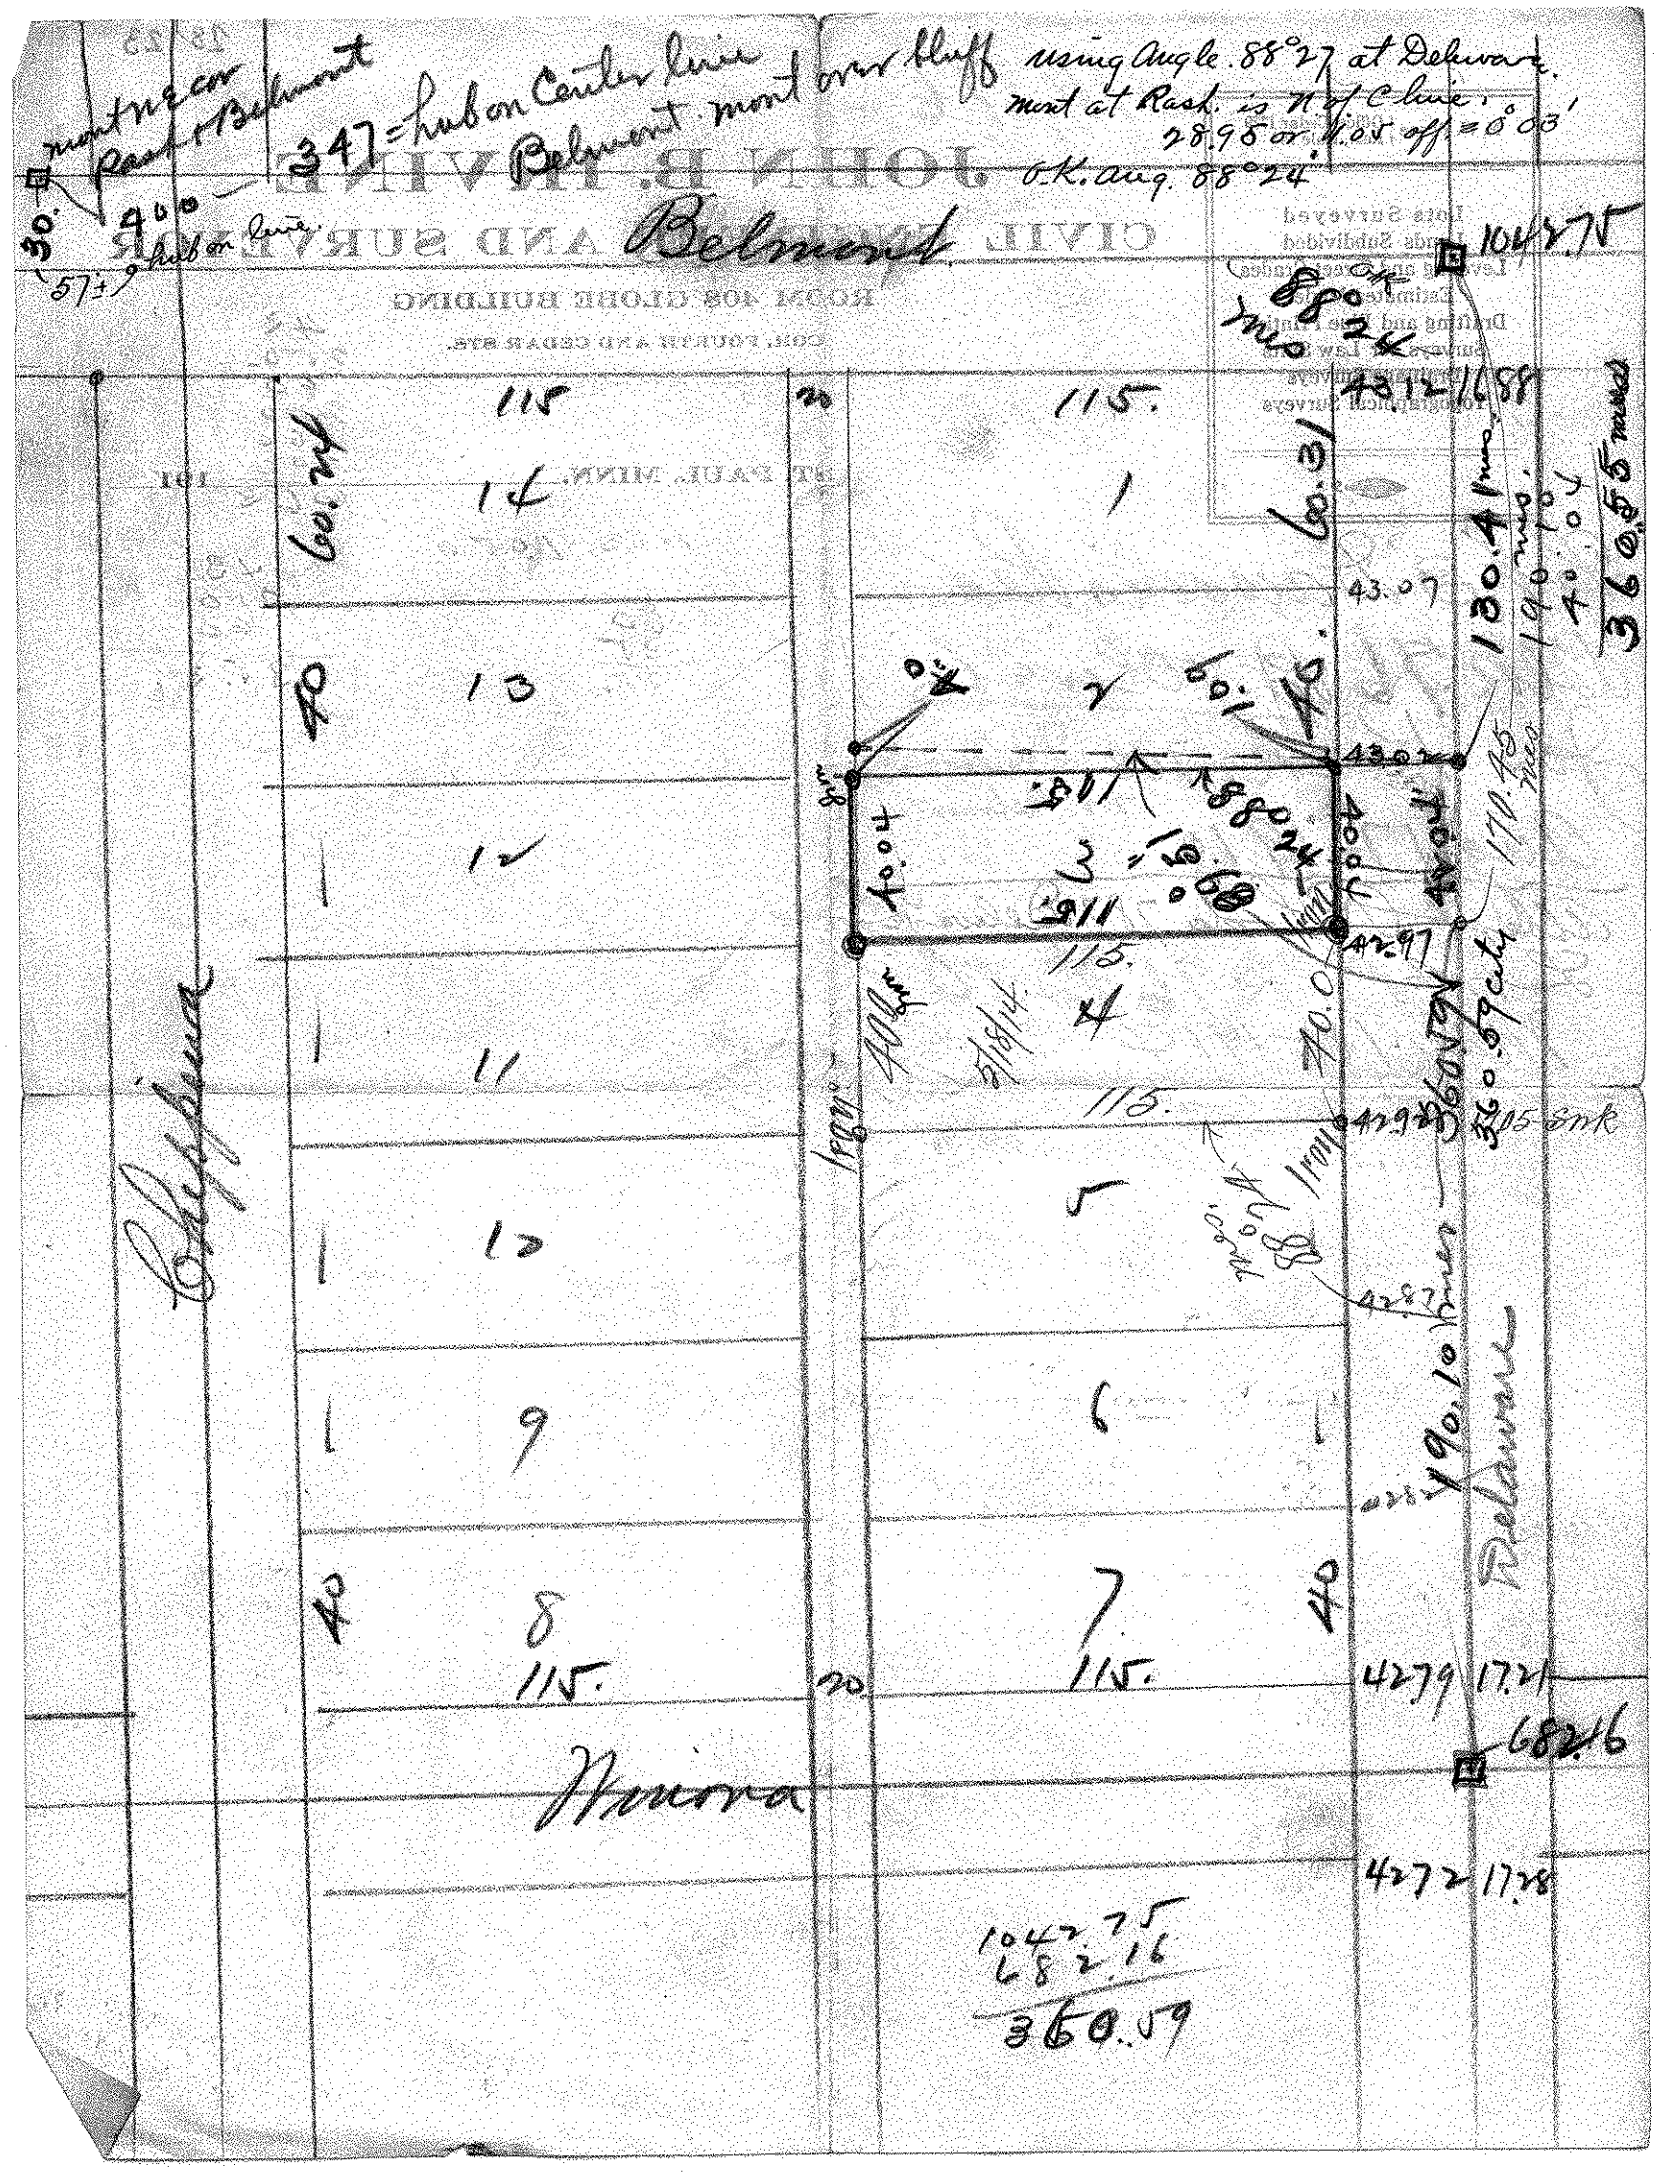

mont NE cor Rash & Belmont
347 = hub on Center line
Belmont mont over bluff
using Angle 88°27 at Delaware
mont at Rash is N of C line
28.95 or 11.05 off = 0°03'
O.K. Ang. 88°24'
30
400
57±9 hub on line
Belmont
1042.75
88°24
43.12 16.88
115
14
1
60.31
43.07
130.41 mes
190.10
40.04
360.55 meas
40
13
2
40.04
43.02
170.45 mes
12
3
115
42.97
11
4
115
42.98
360.59 cats
105 Snk
10
5
42.87
9
6
190.10 mes
Delaware
40
8
7
40
115
115
4279 17.21
682.16
Winona
4272 17.28
1042.75
682.16
360.59