


B. 73

28 23

JOHN B. IRVINE,
COUNTY SURVEYOR

408 GLOBE BLDG.,
4TH & CEDAR STS.

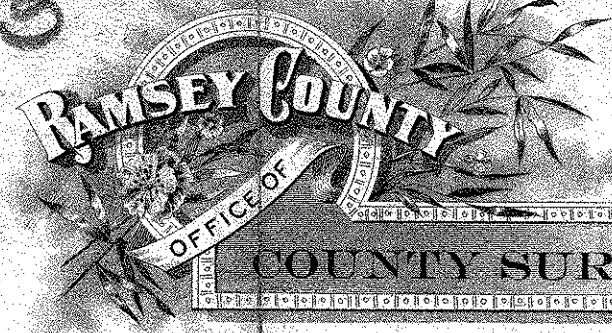

COUNTY SURVEYOR

408 GLOBE BLDG.,
4TH & CEDAR STS.

St. Paul, Minn. 176393

212452
176393
36059

15.90
44.10
60.00

RAMSEY COUNTY COURT HOUSE.

Lots 3 + 4 Bet 73

Banning + Oliver's Add
Eugene D. Fales \$700
110 E 3rd St.

June 8-1909

1458 1000 4.58 - 20.50 - sin E side 751
941 517 - 059 " gutter 4692
955 503 - 046 8 E. drive 706
998 460 - 004 625 5. 749
868 596 - 1320 r. drive 619
518 910 - 492 21 sin E side 219
435 1023 - 515 gutter 25. 186
460 998 - 516 sin 21 sin 211
487 953 - 477
947 692 - 714 516 sin 625 5. 008
