


10.56 10° 10' *Dearborn*
 63.29°
 125
Morton 60
 125 44.89 125 60
 39 185
 184.70 to smk.

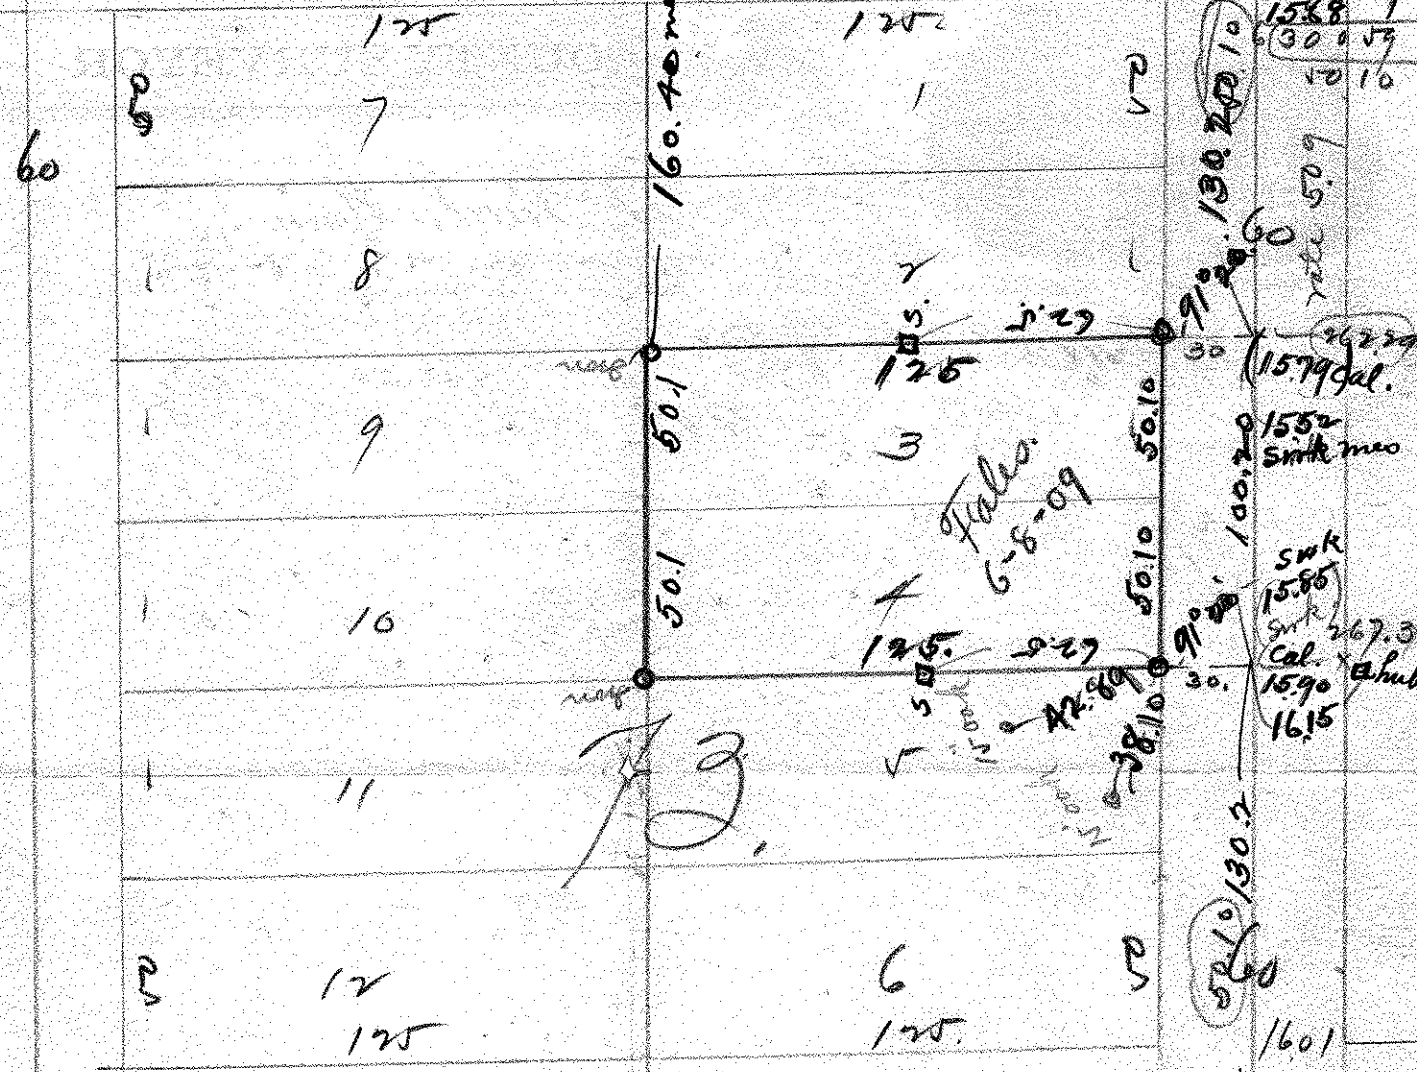

Page OK

Door step to. n.e. cor Page + Delaware 270.04

1568
 1601
 300 | 330211
 30