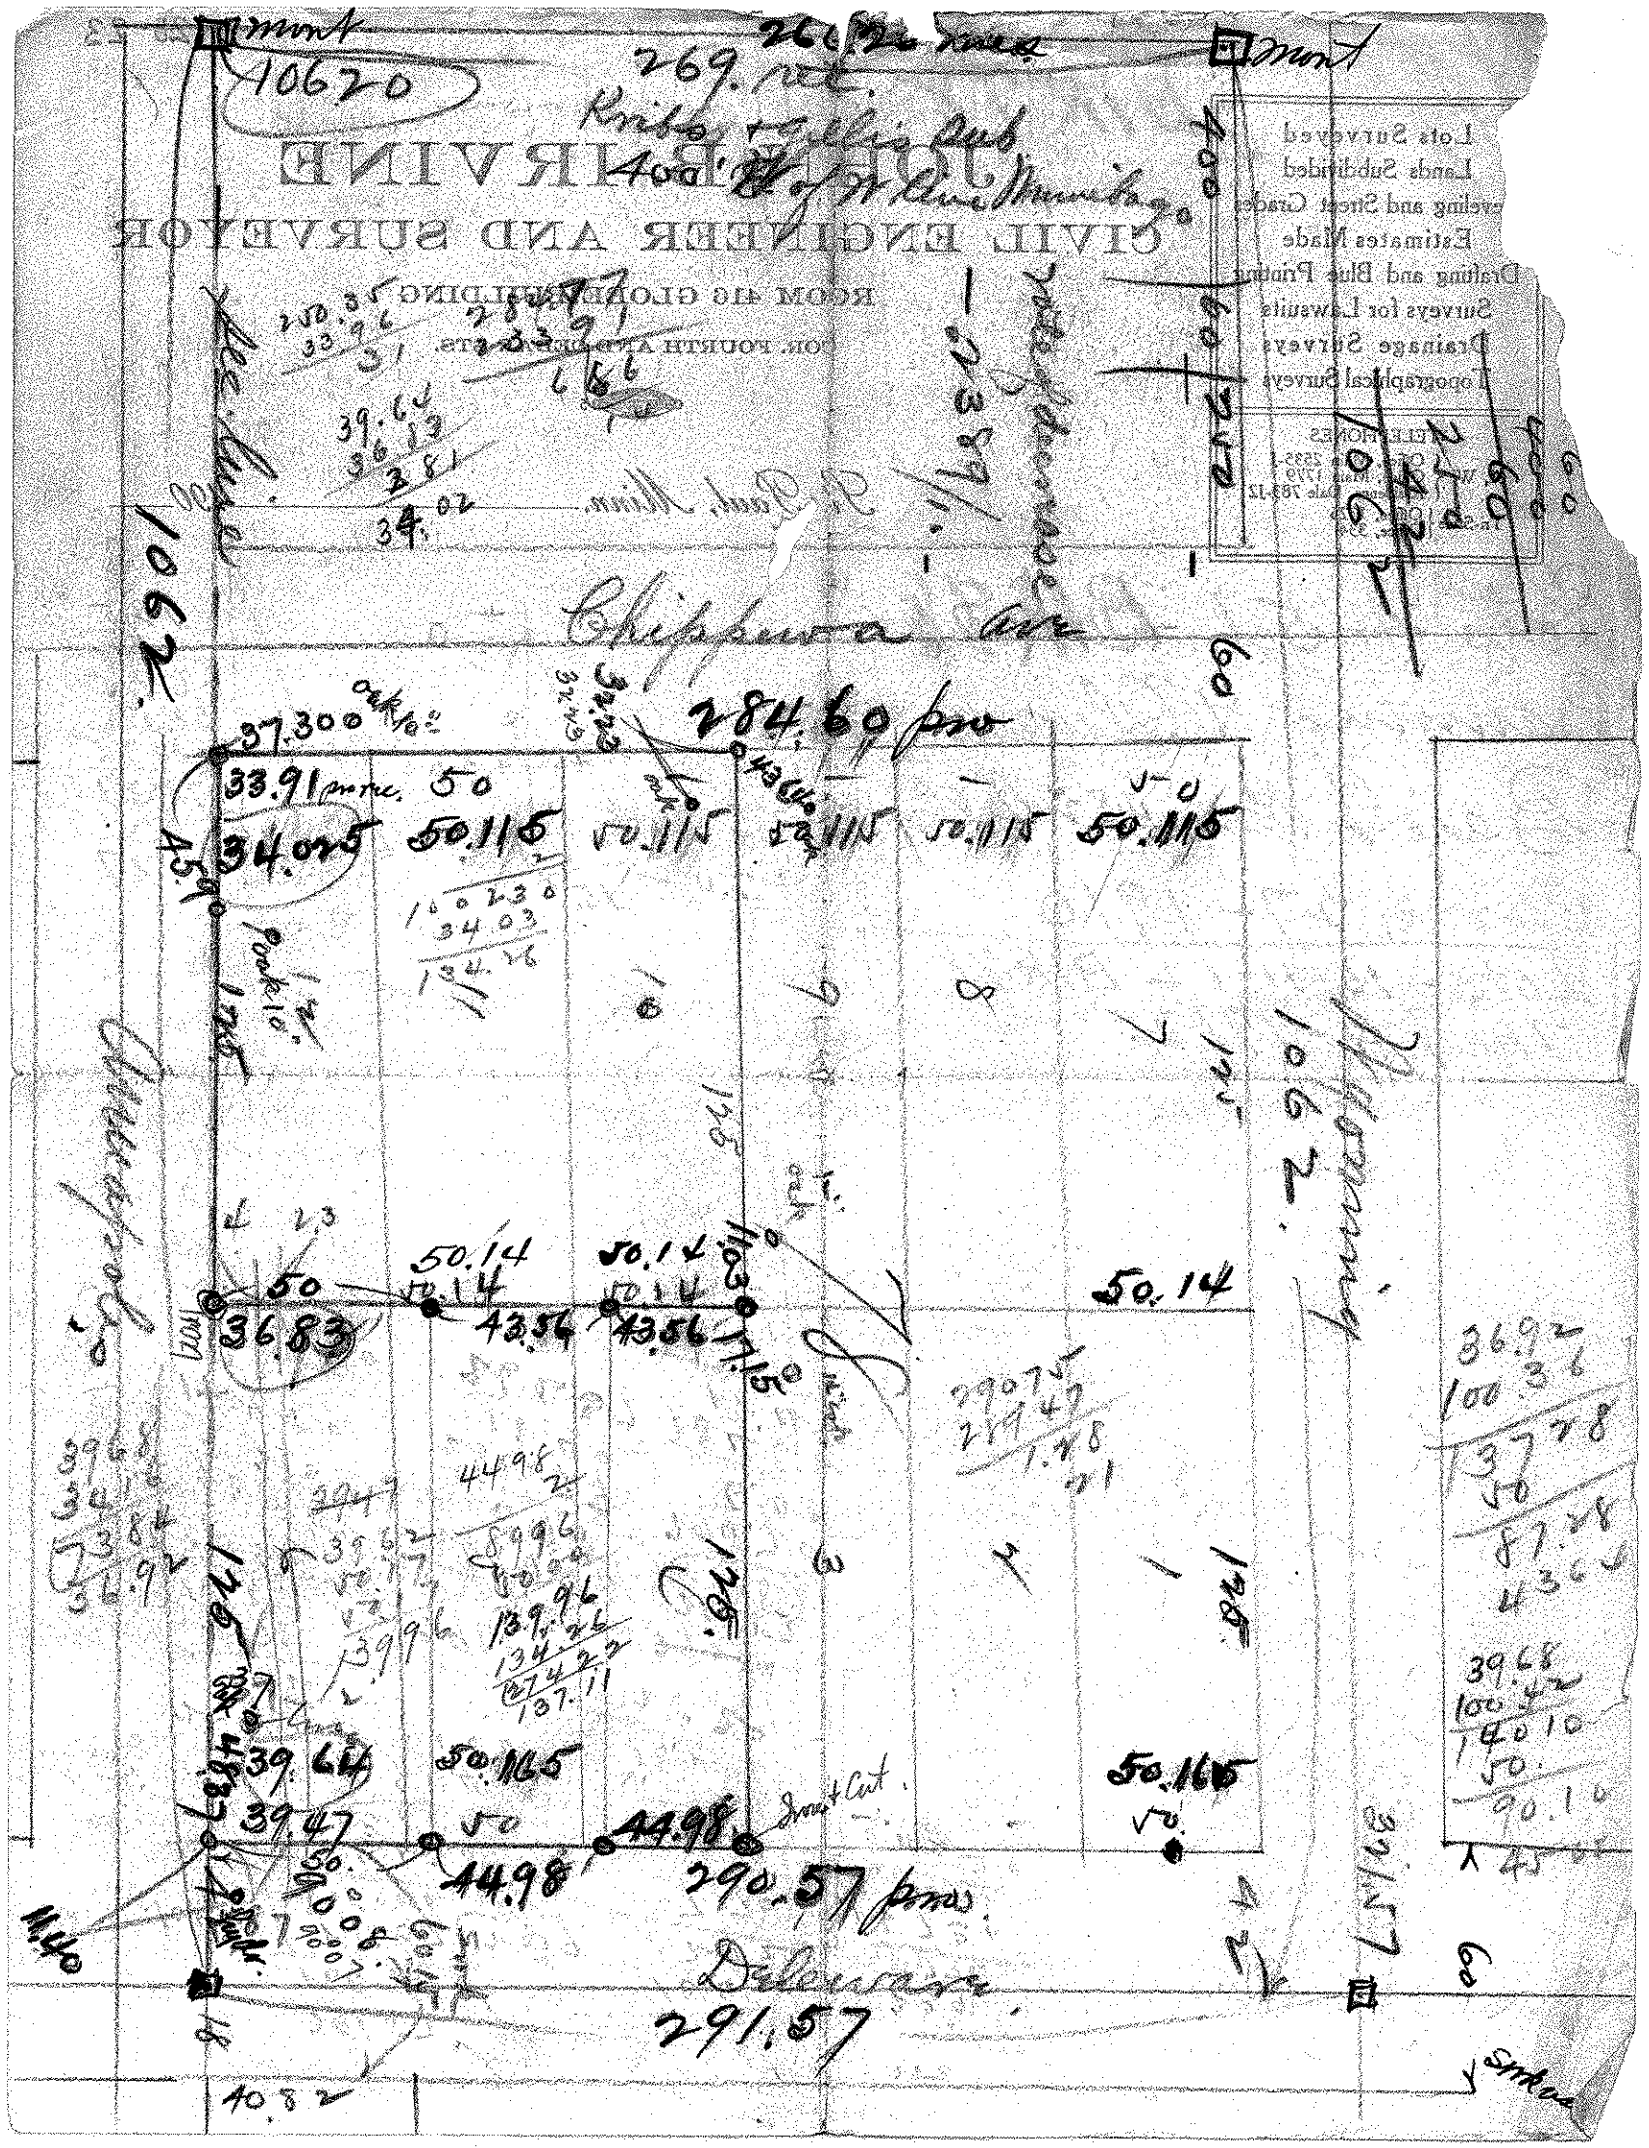
Mount
10620
269. rec.
Knisley
Mount
CIVIL ENGINEER AND SURVEYOR
ROOM 419 GLOBE BUILDING
FOR FOURTH AVE.
Lots Surveyed
Lands Subdivided
Estimates Made
Drafting and Blue Printing
Surveys for Lawsuits
Drainage Surveys
Topographical Surveys
Chippewa
284.60 pro
33.91 proc.
50.115
50.14
43.56
Short Cut
290.57 pros.
Delaware
291.57
Grant