


Blk 72

28 23

JOHN B. IRVINE
COUNTY SURVEYOR



RAMSEY COUNTY COURT HOUSE.

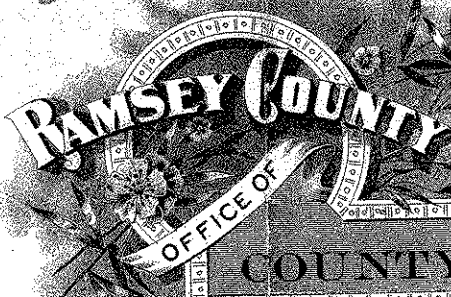

COUNTY SURVEYOR

237.97
9.55
247.52
3.11

44.41
11.11

255.52
5.11

St Paul, Minn.

255.12 255.52 250.38
4.20 4.60 47.10

250.92 250.92 3.77

49.50 200.38 255.11
41.40 47.40 43.5

46.80 255.12 210.78
7.50 46.80

255.12 250.62 + 3.92
2.66 46.80

252.46 + 3.4
49.50 + 3.3 W. E.
3.0+

Lot 12 Blk 72
Dunning + Olivers Add
L. C. Dearborn
259 Bunker
June 29 - 04
May 16 - 1909

1257
1300

300 / 13 (633)
12 / 100

Lot 6 Blk 72
Dunning + Olivers
H. A. Johnson
Apr. 19-1911

1330 1048
