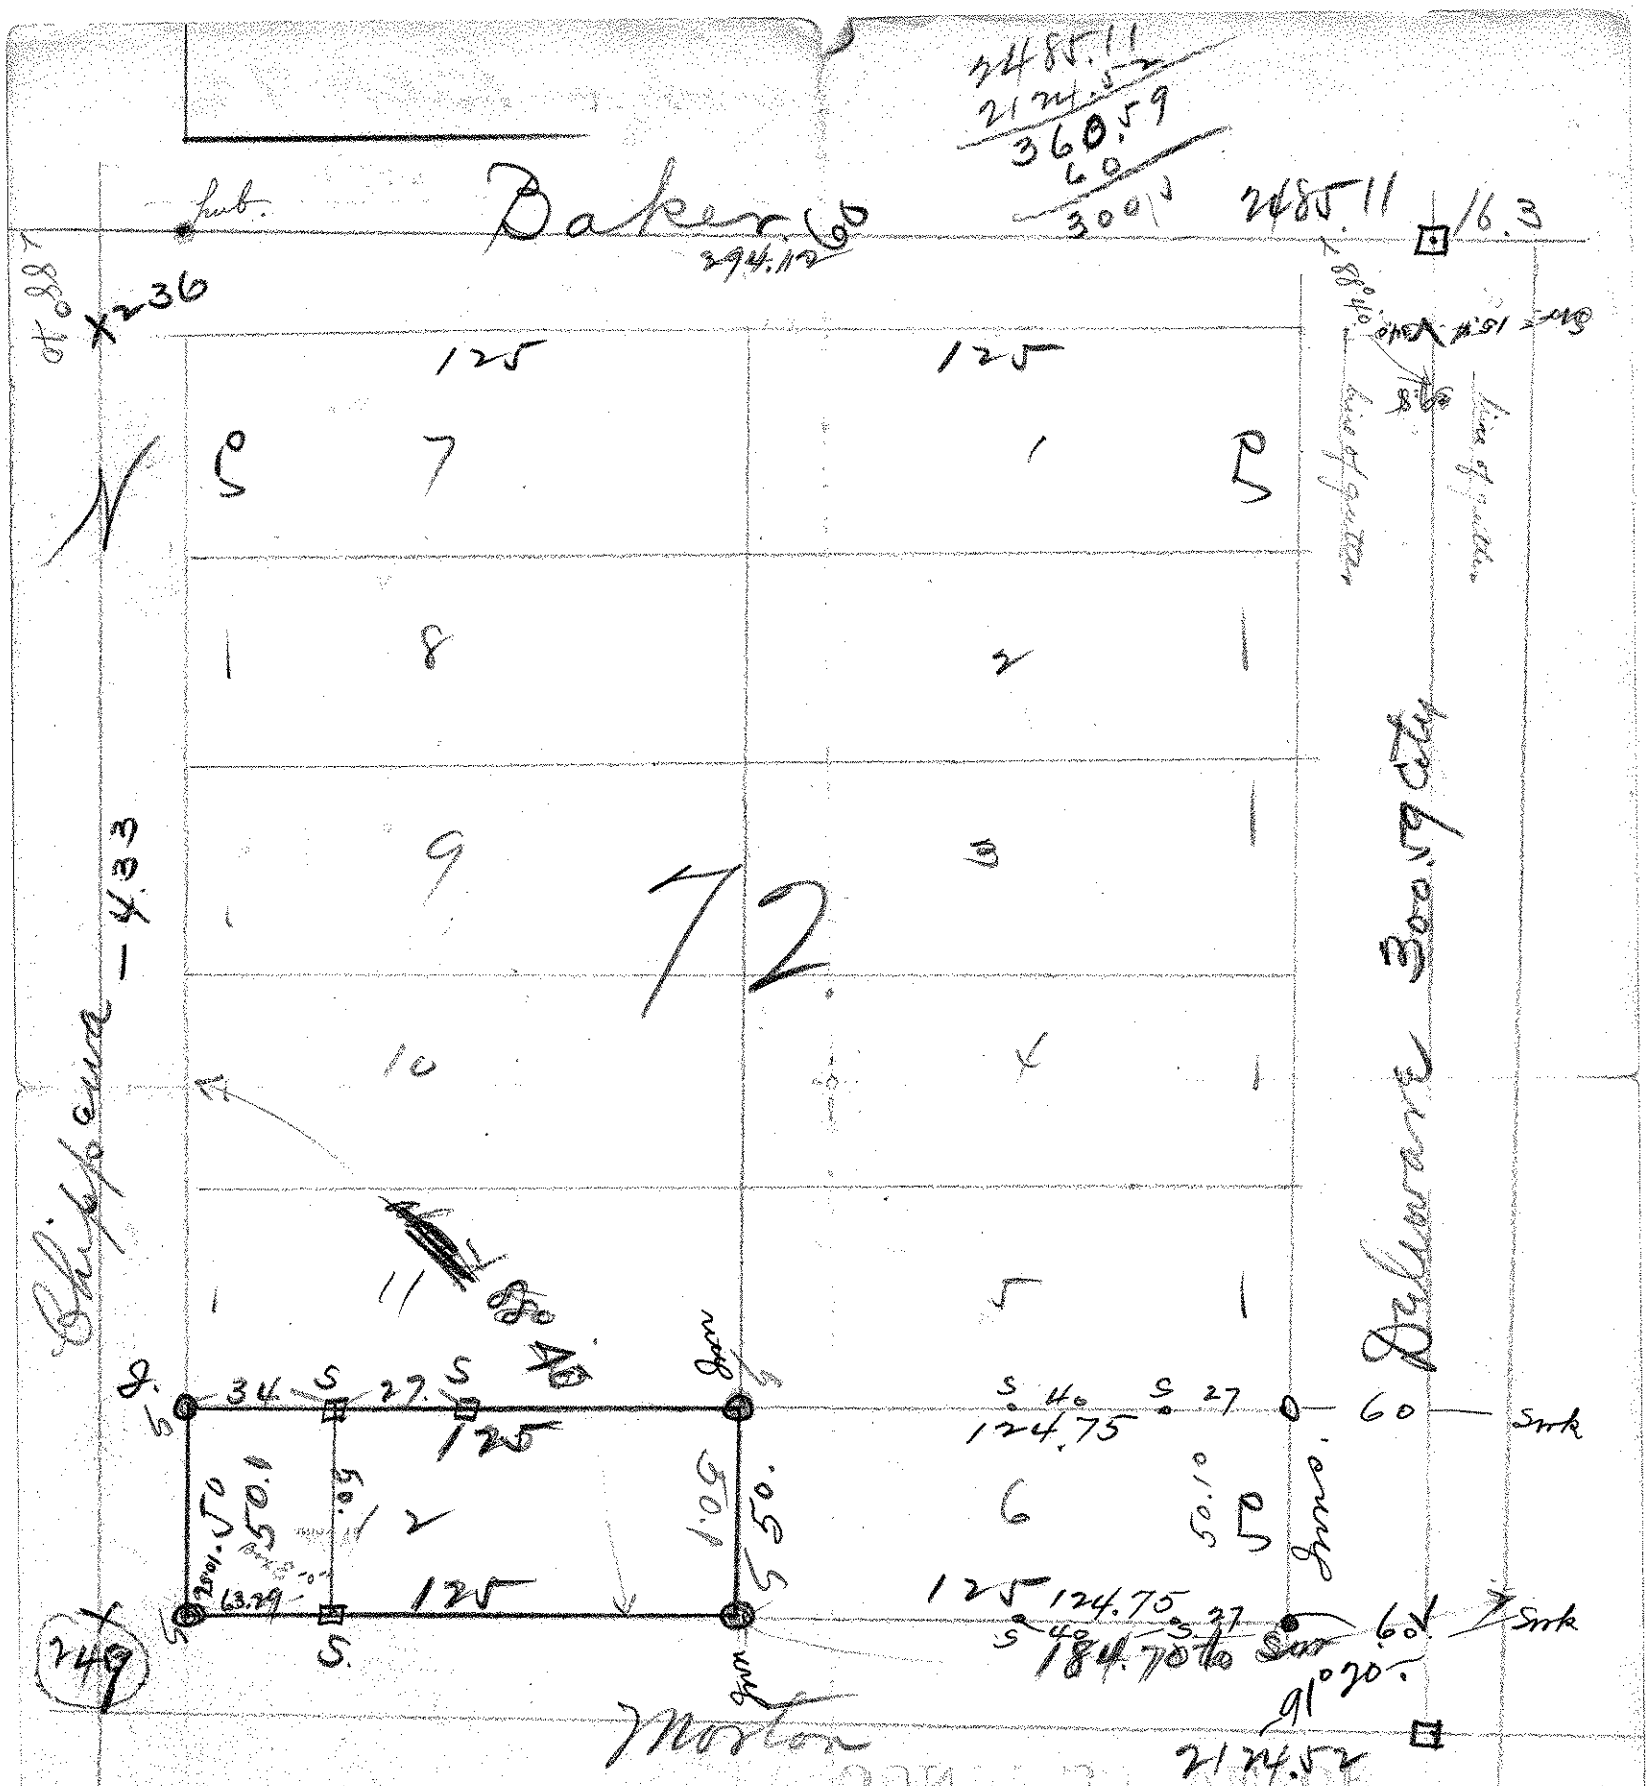

9.55 247.52 237.97 B.M. Mont 140' n.c. Baker.
T.P. 11.11 255.52 3.11 244.41
5.14 250.38 - Inn. mr cor. lot 247.34 +3.0
4.60 250.92 dotted S.W. " " - 249.5 +1.4
4.74 255.12 250.38 grade
4.50 250.62 - 247.34 - +3.3
4.34 250.78 247.34 +3.4