

Topographical surveys
 drainage surveys
 surveys for gas lines
 locating and line plotting
 estimates made
 locating and survey grades
 lands subdivided and
 lots surveyed





BEYOND THIS LINE

101

Snyder

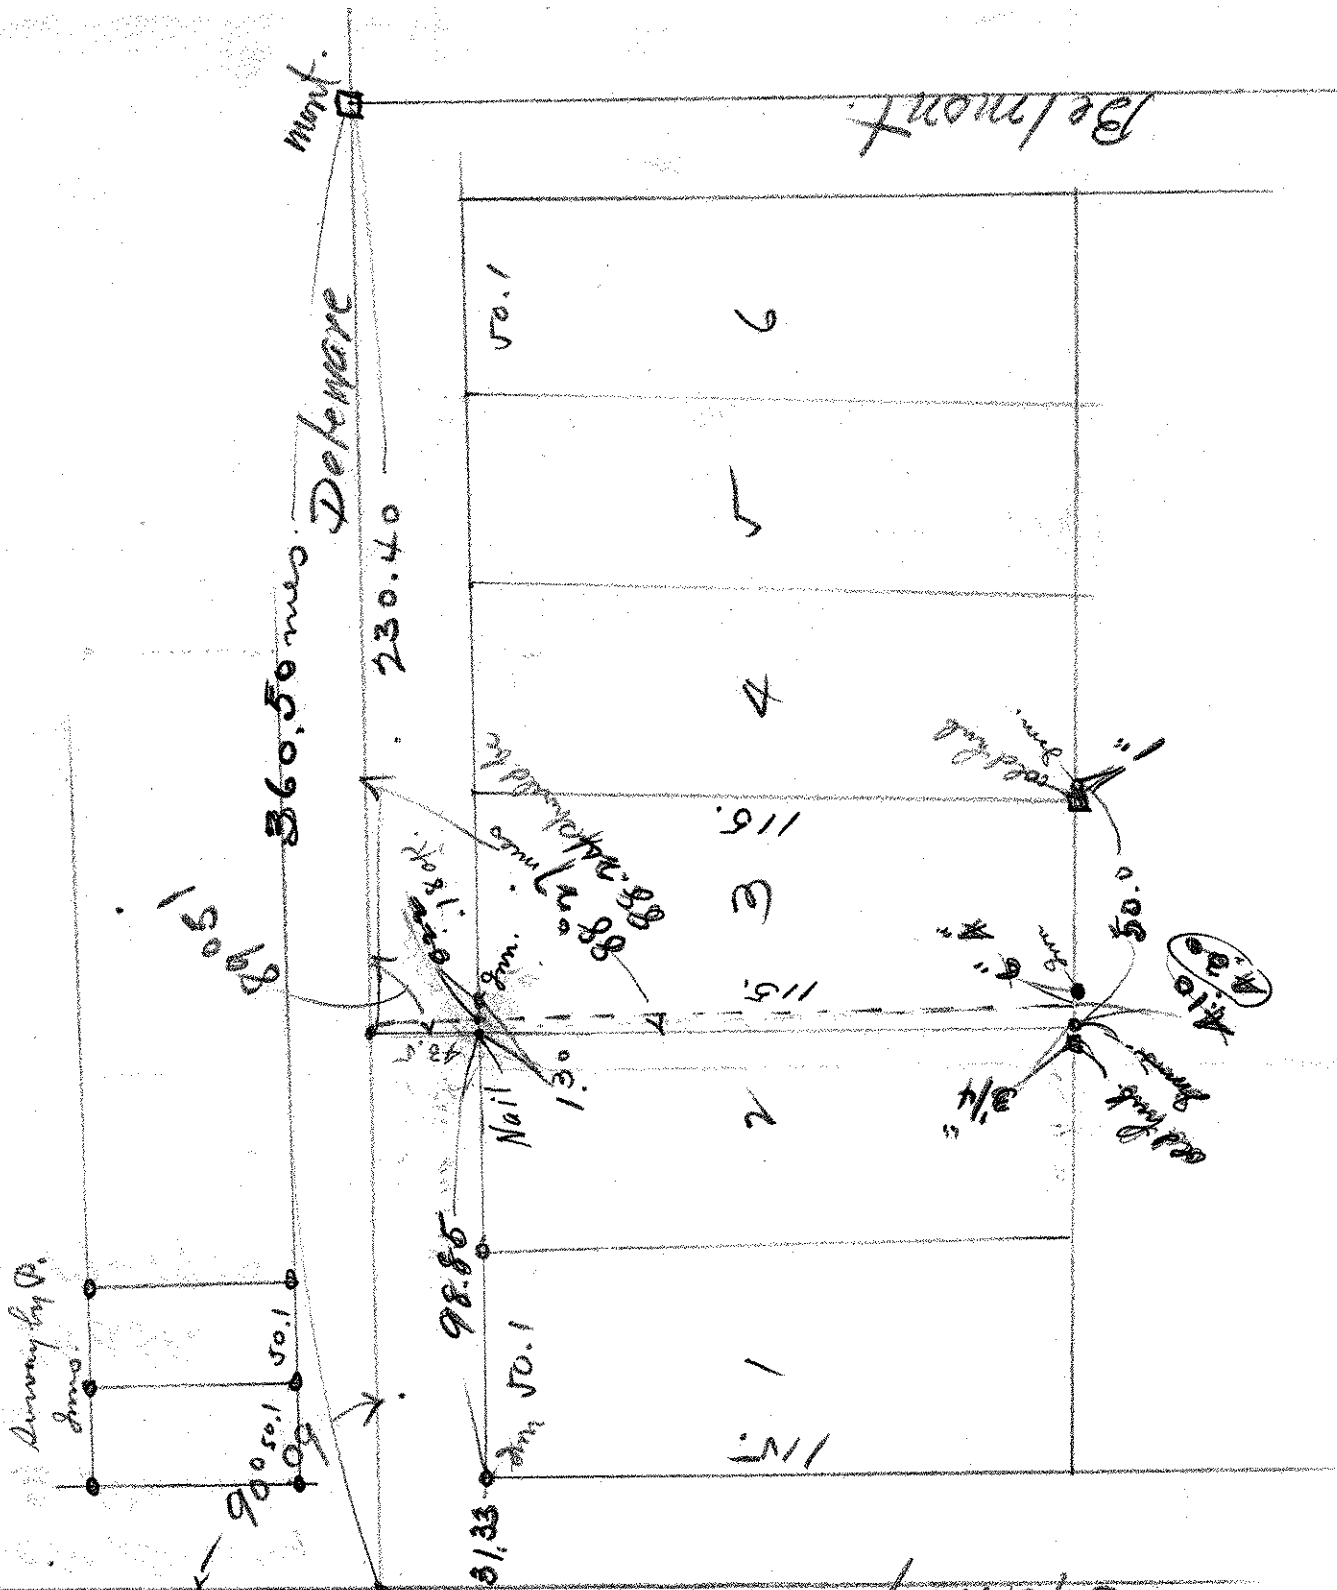

100.1
 115
 130

101