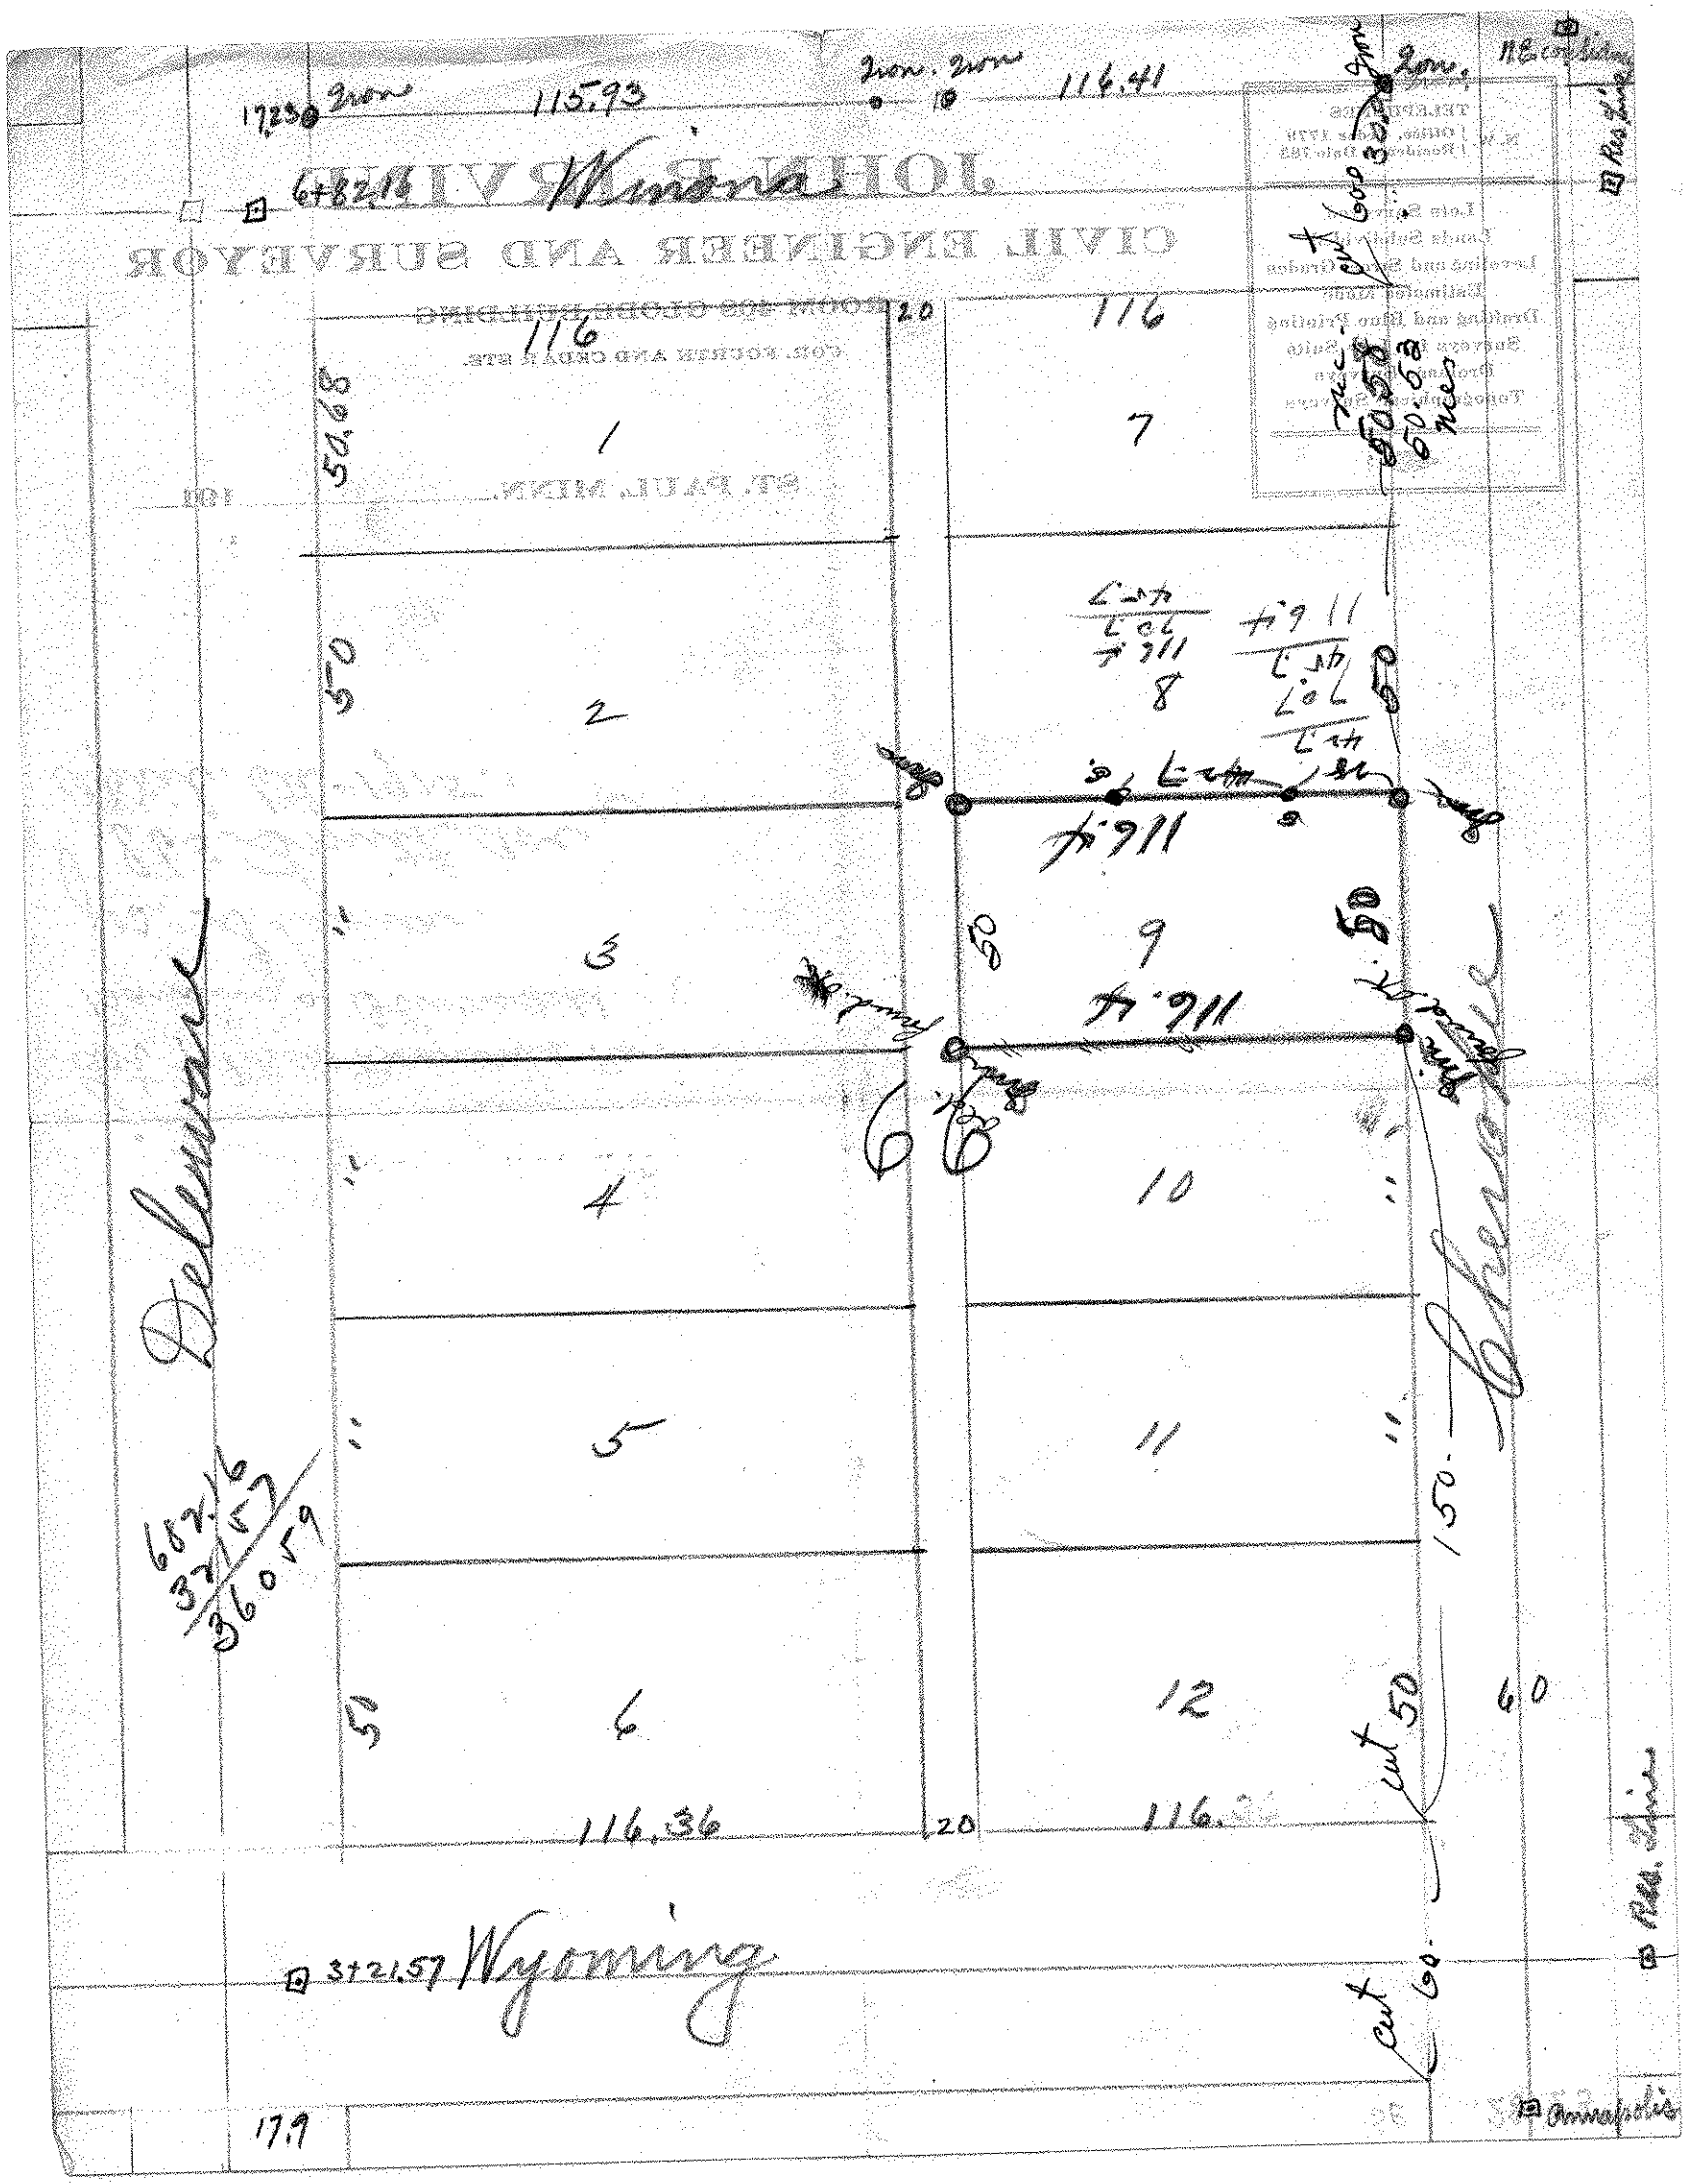

17.23 Iron
115.93
Iron. Iron
116.41
Iron
Winona
6+82.16
116
116
1
7
50.68
2
8
50
3
9
50
4
10
5
11
6
12
50
116.36
20
116.36
Delaware
Cherokee
150.
60
cut 50
cut 60
3+21.57 Wyoming
17.9
Annapolis