NE 1/28 23

FROM THE OFFICE OF

CHARLES O. GEORGI COMPANY

2215 West County Road B — Saint Paul, Minnesota 55113

REGISTERED CIVIL ENGINEER AND LAND SURVEYOR

Certificate of Survey

Project No. Minn A-1-1
Parcel No. 134A
Area - see each description

I Hereby Certify that this plat shows a survey made by me of the property described on this plat, and that the corners are correctly placed as shown, and that all locations have been correctly shown. 9/30/76 Added Ironson Alley & proposed Alley widening.

Surveyed For Housing Authority

Date August 1976

Scale 1" = 60'

By Charles O. Georgi
REGISTERED LAND SURVEYOR

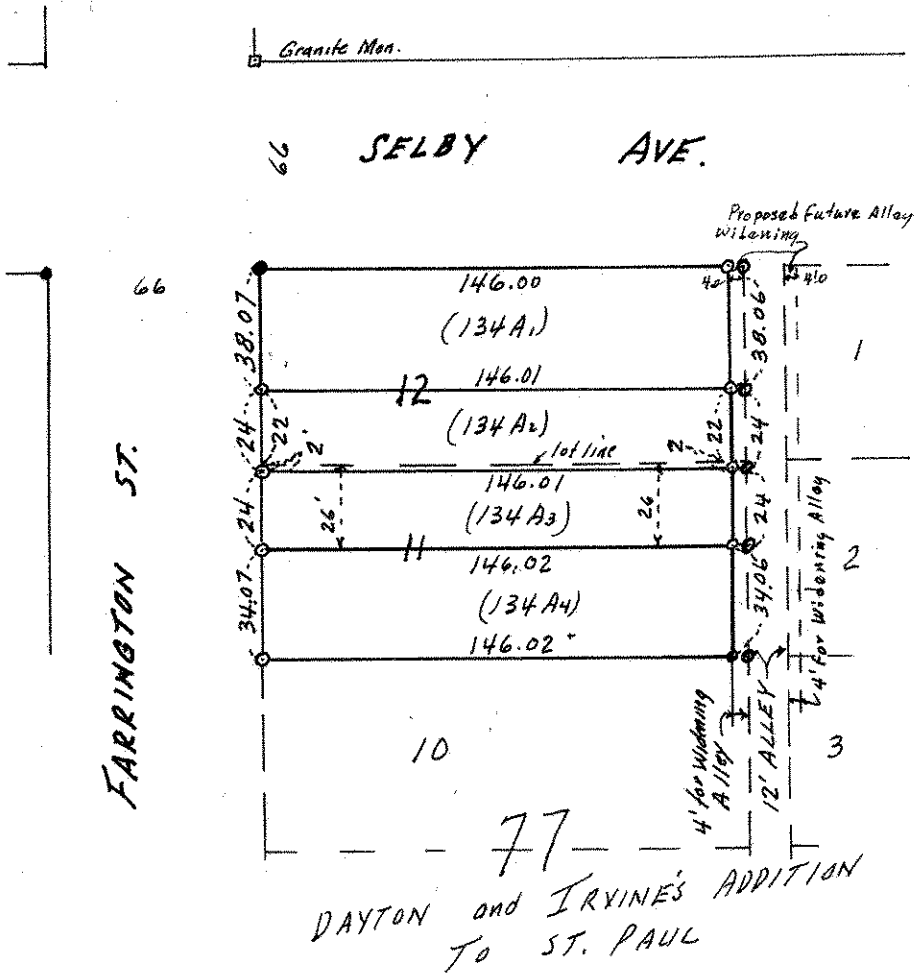

o Denotes Iron Pipe Monument

• Denotes Iron found in place.

All distances are to hundredths of a foot.

Description: (134 A1)
Lot 12 except the South 22 feet thereof and except the East 4 feet thereof, Block 77, Dayton and Irvine's Addition to St. Paul
Contains: 5,558 Sq. Ft., m.o.l.

Description: (134 A2)
The South 22 feet of Lot 12 except the East 4 feet thereof and the North 2 of Lot 11 except the East 4 feet thereof, Block 77, Dayton and Irvine's Addition to St. Paul
contains: 3,504 Sq. Ft, m.o.l.

Description: (134 A3)
The South 24 feet of the North 26 feet of Lot 11 except the East 4 feet thereof, Block 77, Dayton and Irvine's Addition to St. Paul
Contains 3,504 Sq. Ft., m.o.l.

Description: (134 A4)
Lot 11 except the North 26 feet thereof and except the East 4 feet thereof, Block 77, Dayton and Irvine's Addition to St. Paul.
Contains 4,974 Sq. Ft., m.o.l.