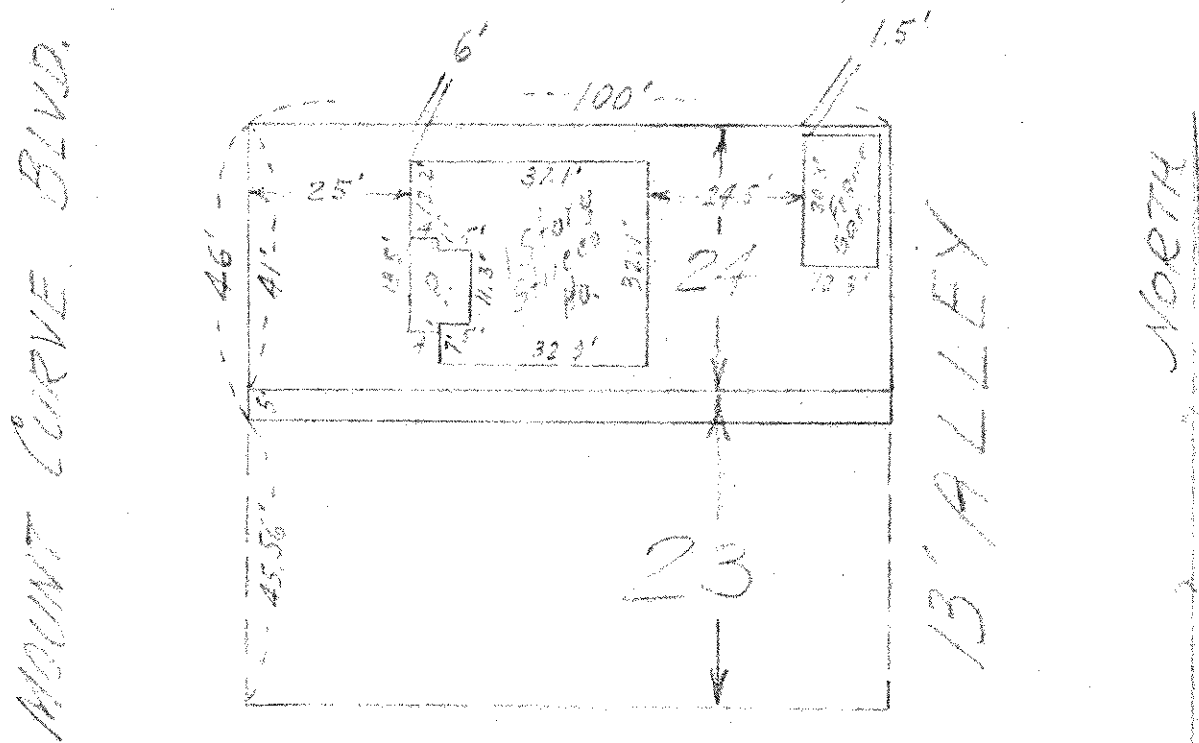


TELEPHONE 776-0640

PLAT OF SURVEY

OF PROPERTY OF Jack J. CoopermanDESCRIBED AS FOLLOWS The Northerly 5' of Lot 23 and all of Lot 24, Block 1, in Mississippi
View being Auditor's Subdivision No 59
No 442 Mount Curve Blvd, St Paul, Minn.

SCALE: 1 INCH = 30 FEET

T. J. WELCH, REGISTERED SURVEYOR
701 EAST 3RD STREET, ST. PAUL, MINN. 55106

CERTIFICATE OF SURVEY

I hereby certify that on Sept. 16, 1965I surveyed the property described above and that the above
plat is a correct representation of said survey.T. J. Welch315/
29