8 28 23

PLAT OF SURVEY

OF PROPERTY OF H.C. Lindquist and North ½ Lot C

DESCRIBED AS FOLLOWS Lot 22, Block 2, Auditors Subdivision No. 59

being Mississippi View.

SCALE: 1 INCH 30 FEET.

T. J. WELCH, REGISTERED SURVEYOR
738 VAN BUREN PLACE, ST. PAUL, MINN.

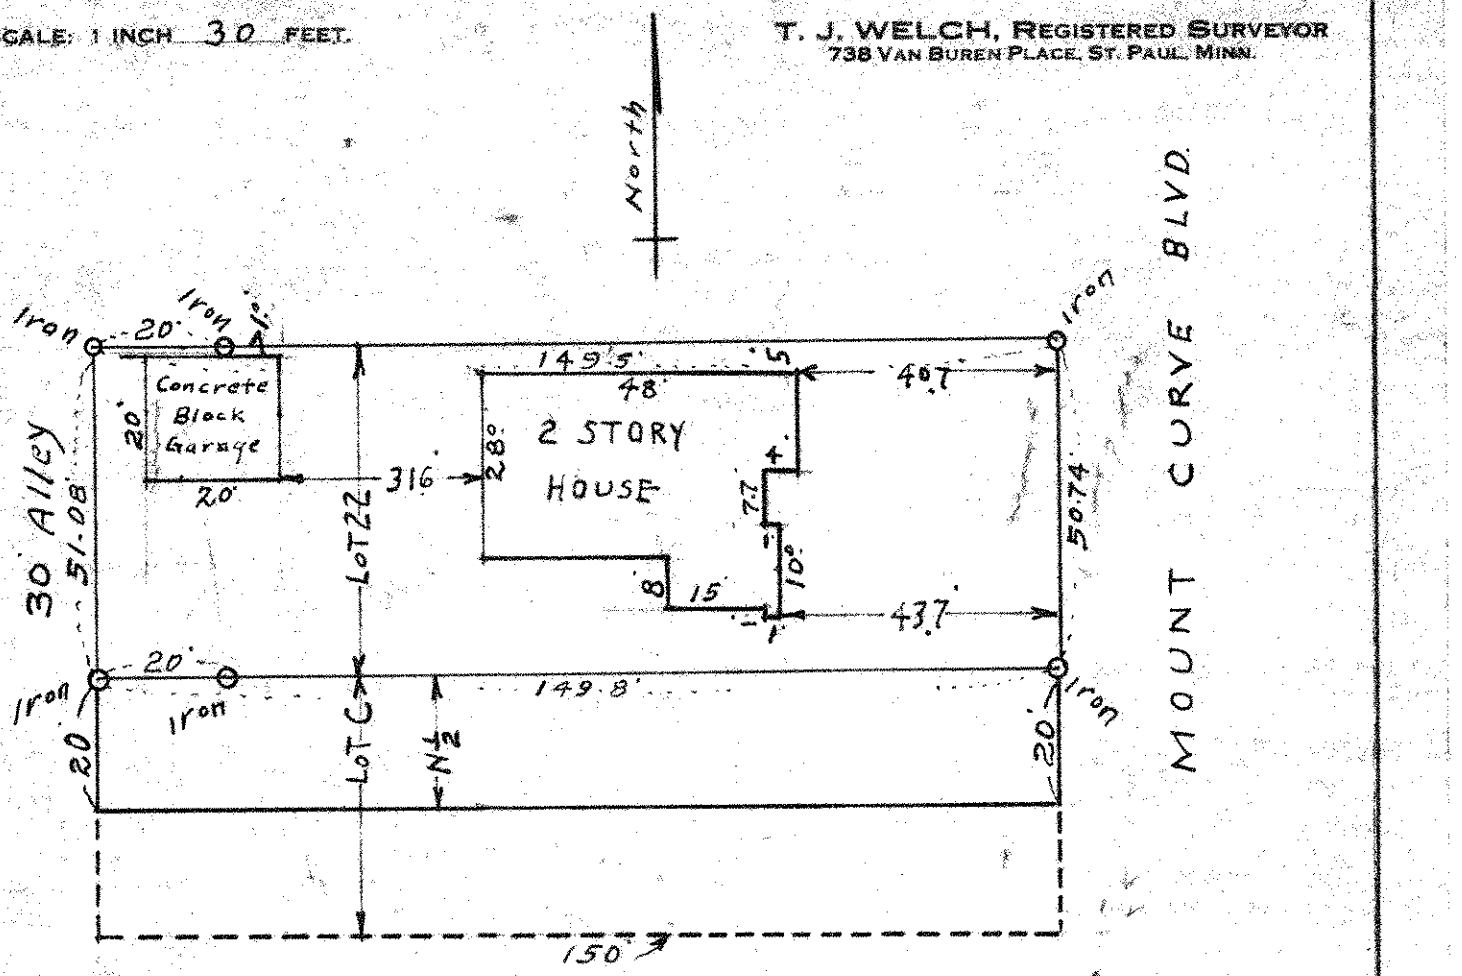

CERTIFICATE OF LOCATION OF BUILDING

I hereby certify that on May 7, 1936 I made a survey of the location of the building on the above described property and that the location of said building is correctly shown on the above plat.

T. J. Welch

CERTIFICATE OF SURVEY

I hereby certify that on Feb. 22, 1936 I surveyed the property described above and that the above plat is a correct representation of said survey.

T. J. Welch