

PLAT OF SURVEY

8 28 23


OF PROPERTY OF _____

DESCRIBED AS FOLLOWS *Lot 24, Block 2 Mississippi View being Auditor's Sub. No 59.*

SCALE: 1 INCH *30* FEET.

○ - Indicates Iron.

T. J. WELCH, REGISTERED SURVEYOR
738 VAN BUREN PLACE, ST. PAUL, MINN.

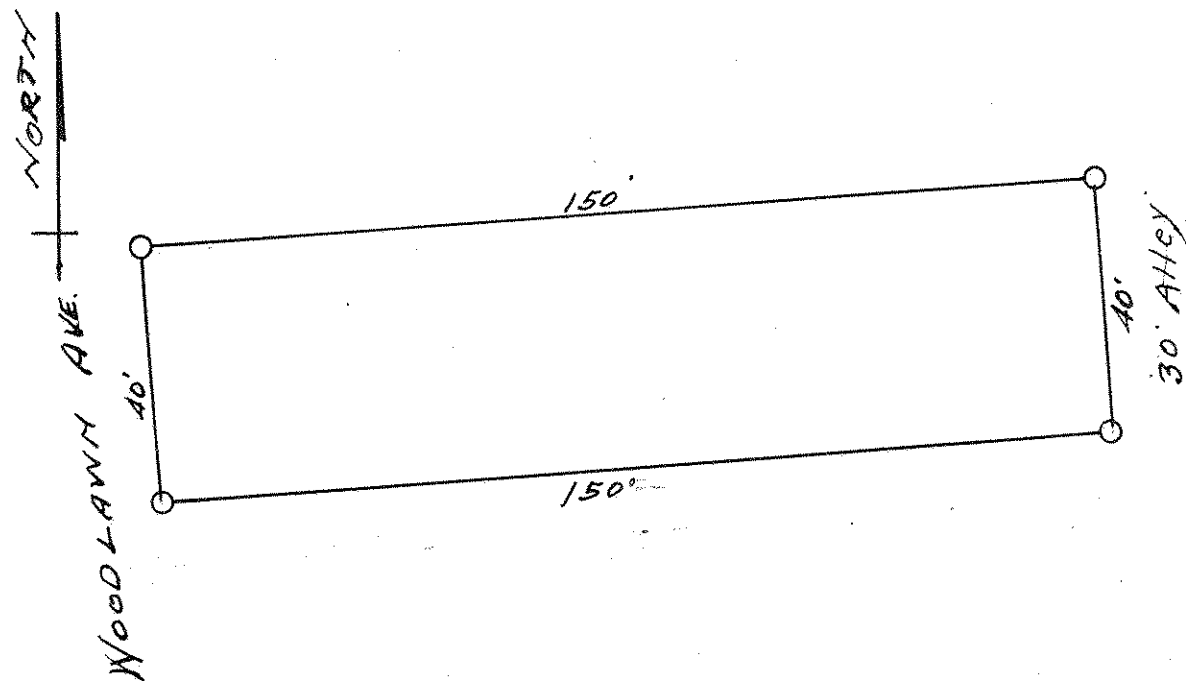

CERTIFICATE OF LOCATION OF BUILDING

I hereby certify that on _____ 19____
I made a survey of the location of the building on the above
described property and that the location of said building is
correctly shown on the above plat.

CERTIFICATE OF SURVEY

I hereby certify that on *June 17,* 19 *39*
I surveyed the property described above and that the above
plat is a correct representation of said survey.

T. J. Welch