PLAT OF SURVEY

OF PROPERTY OF Edson A. Roach


DESCRIBED AS FOLLOWS Lot 10, Block I, Mississippi View, being Auditor's

Subdivision No. 59, St. Paul

No. 397 Cretin Ave., St. Paul, Minn.

SCALE: I INCH 29 FEET.

T. J. WELCH, REGISTERED SURVEYOR 738 VAN BUREN PLACE: ST. PAUL. MINN.

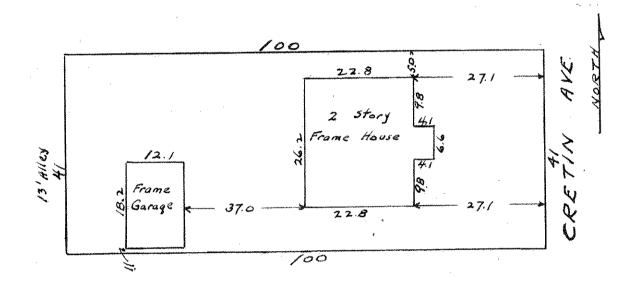

CERTIFICATE OF LOCATION OF BUILDING

I hereby certify that on April 5 1938
I made a survey of the location of the building on the above described property and that the location of said building is correctly shown on the above plat.

I. J. Weldy

CERTIFICATE OF SURVEY

I hereby certify that on April 5 1938.

I surveyed the property described above and that the above plat is a correct representation of said survey.