

8 28 23


PLAT OF SURVEY

OF PROPERTY OF _____

DESCRIBED AS FOLLOWS Lot 3, and the South $\frac{1}{2}$ of Lot 2, Block 3, Mississippi View being Auditors Sub. No. 59 373 Woodlawn Ave - St. Paul, Minn.

SCALE: 1 INCH = 30 FEET

T. J. WELCH, REGISTERED SURVEYOR
738 SURREY AVENUE, ST. PAUL, MINN.

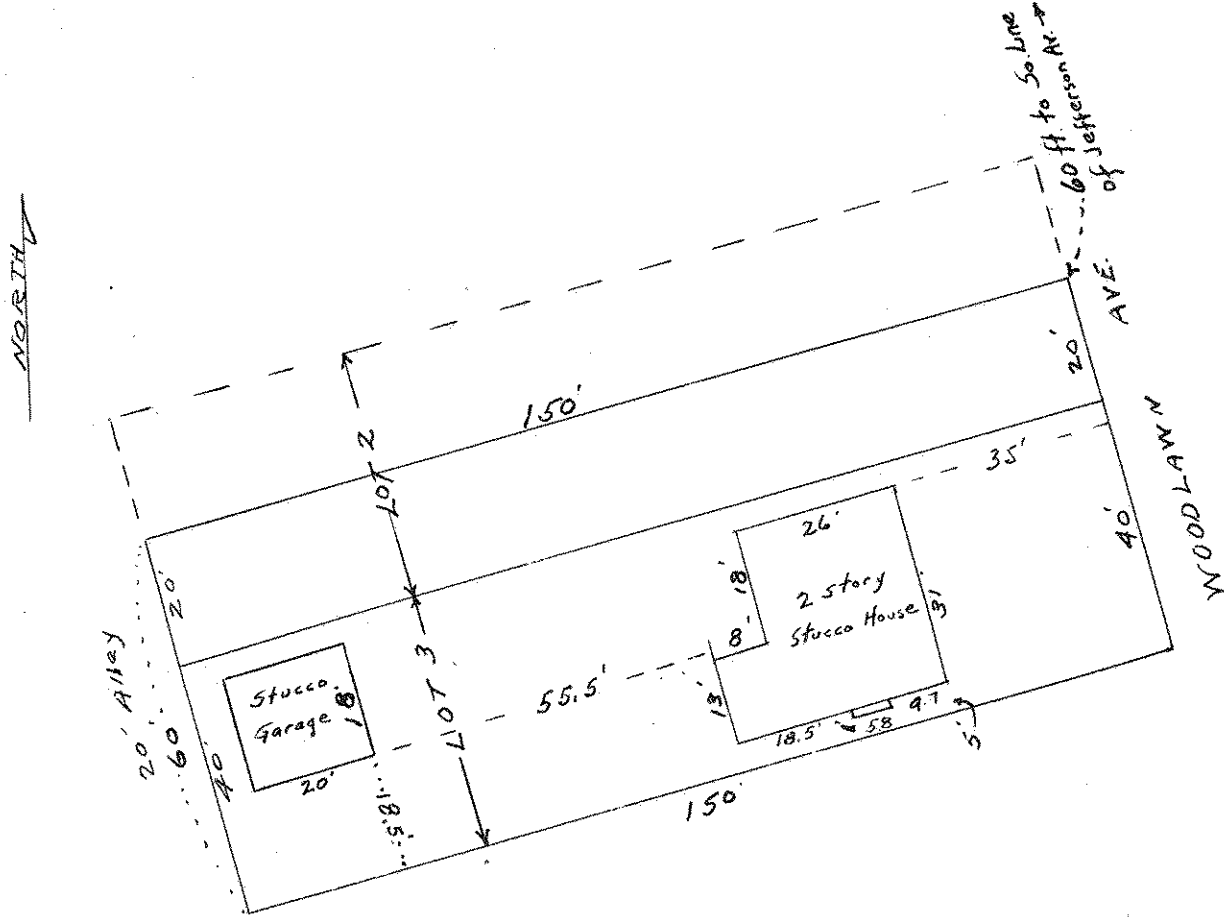

CERTIFICATE OF LOCATION OF BUILDING

I hereby certify that on Dec. 18, 1941
I made a survey of the location of the building on the above
described property and that the location of said building is
correctly shown on the above plat.

J. J. Welch

CERTIFICATE OF SURVEY

I hereby certify that on Dec. 18, 1941,
I surveyed the property described above and that the above
plat is a correct representation of said survey.

J. J. Welch