PLAT OF SURVEY

8 28 23

OF PROPERTY OF Geo. Dunn

DESCRIBED AS FOLLOWS Lot 19, Block 1, Mississippi View, being Auditor's Subdivision No 59

No 433 So. Cretin Ave. — St. Paul, Minn.

SCALE: 1 INCH 20 FEET.

T. J. WELCH, REGISTERED SURVEYOR
738 VAN BUREN PLACE, ST. PAUL, MINN.

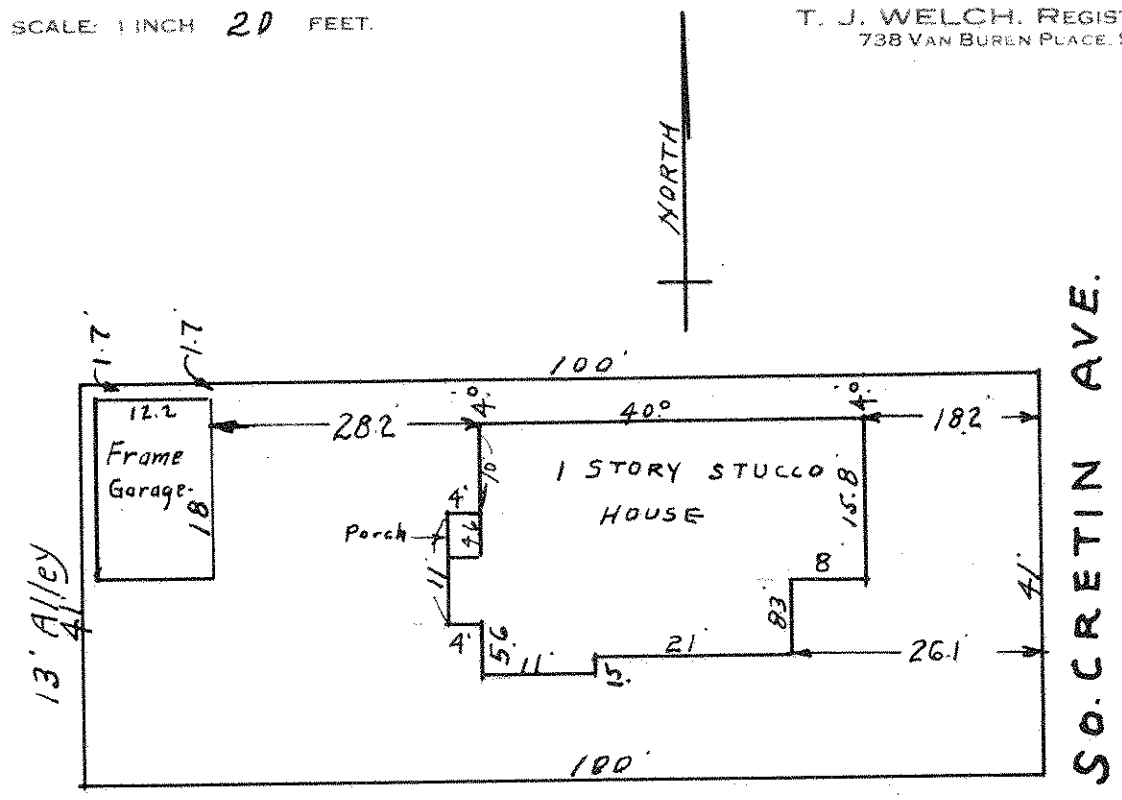

CERTIFICATE OF LOCATION OF BUILDING

I hereby certify that on May, 14, 1936 I made a survey of the location of the buildings on the above described property and that the location of said buildings is correctly shown on the above plat.

T. J. Welch

CERTIFICATE OF SURVEY

I hereby certify that on May, 14, 1936 I surveyed the property described above and that the above plat is a correct representation of said survey.

T. J. Welch