


FROM THE OFFICE OF

CHARLES O. GEORGI COMPANY

2215 West County Road B Saint Paul, Minnesota 55113

REGISTERED CIVIL ENGINEER AND LAND SURVEYOR

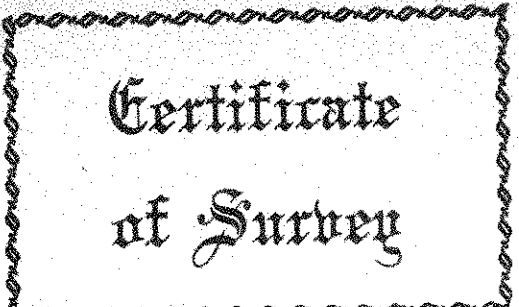

I Hereby Certify that this plat shows a survey made by me of the property described on this plat, and that the corners are correctly placed as shown, and that all locations have been correctly shown.

Surveyed For Housing Authority
Date April 1977
Scale 1" = 100'

SUMMIT PLACE DEVELOPMENT -
Contract No. 77-1 CD Districts 8, 9, 17
Phase 1: 36,040 sq ft, m.o.l.
Phase 2: 27,080 sq ft, m.o.l.
Phase 3: 45,080 sq ft, m.o.l.
Phase 4:

By Charles O. Georgi
REGISTERED LAND SURVEYOR

- DESCRIPTIONS:
- (Phase 1) Lots 7 thru 10, Block 77, Dayton and Irvine's Addition to St. Paul.
 - (Phase 2) Lots 1 thru 3, W.C. Riley's Rearrangement and Lot 4, Block 77, Dayton and Irvine's Addition to St. Paul.
 - (Phase 3) Lots 1, 2, 3, 11, and 12, Block 77, Dayton and Irvine's Addition to St. Paul.
 - (Phase 4) Lots 1 and 2, Block 76, Dayton and Irvine's Addition to St. Paul, lots 3 thru 17, and lots 31, and 32, Auditor's Subdivision No. 52.

Ramsey County, Minnesota



o Denotes Iron Monument

