


LOT 3  
AUDITOR'S SUB'D.  
No 52.

SELBY AVE.

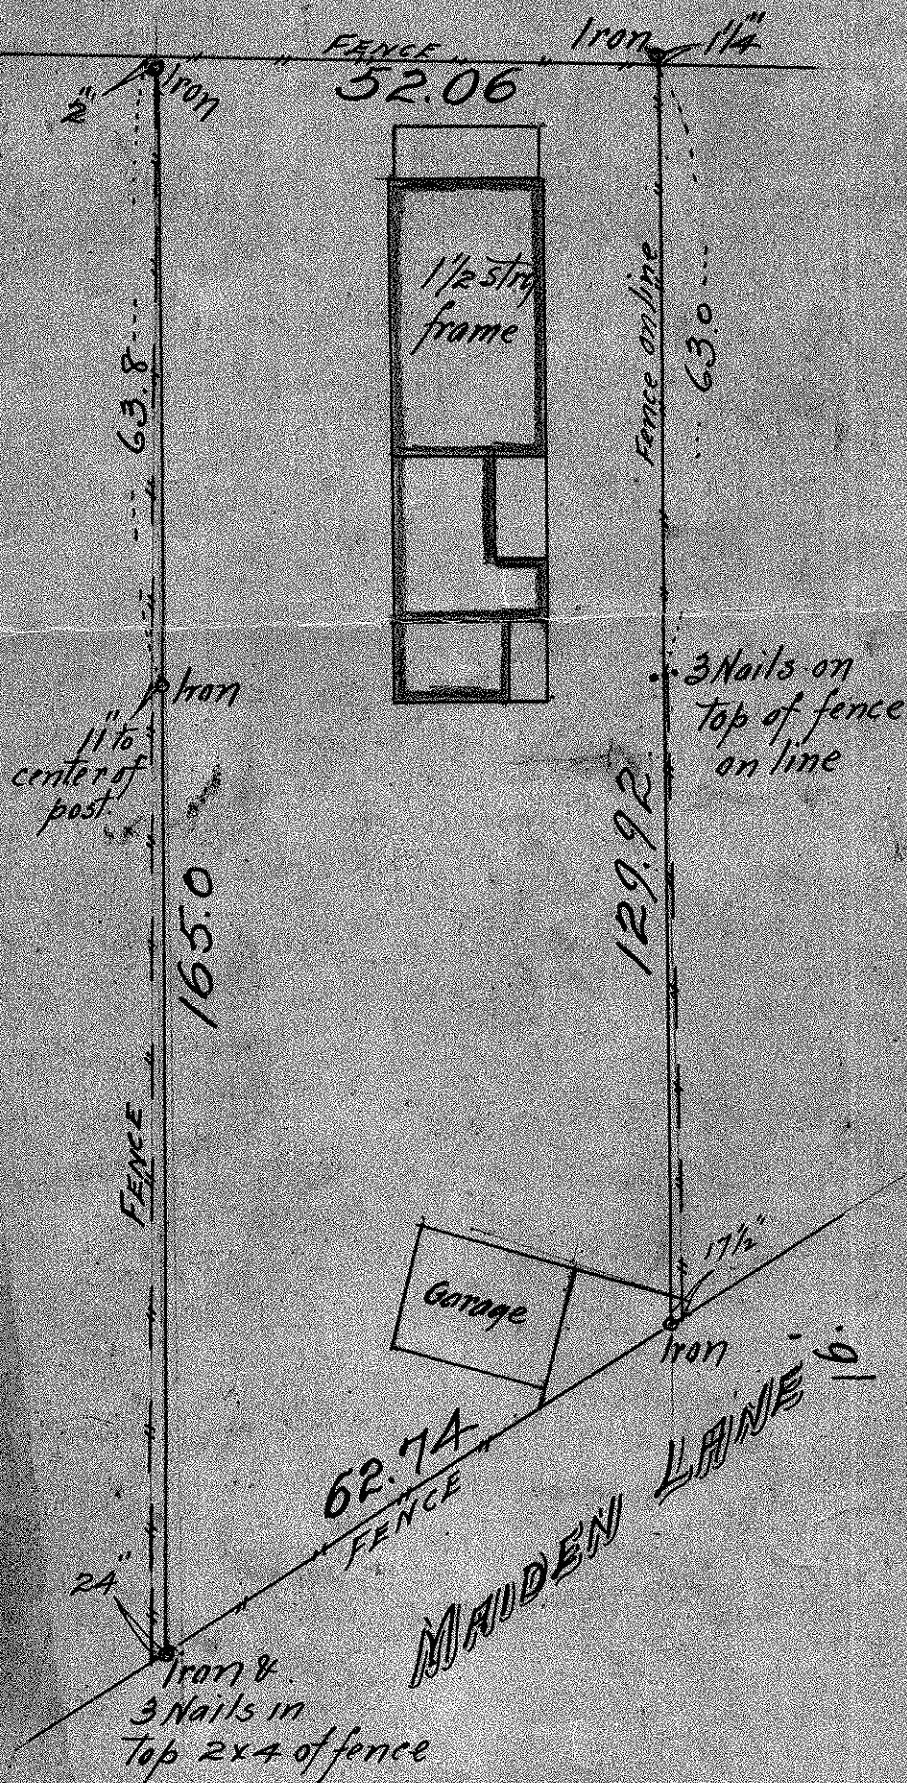

JOHN B. IRVINE, SURVEYOR.

ST. PAUL, MINN.

MARCH 26-1919.

Scale 20 ft. per inch.