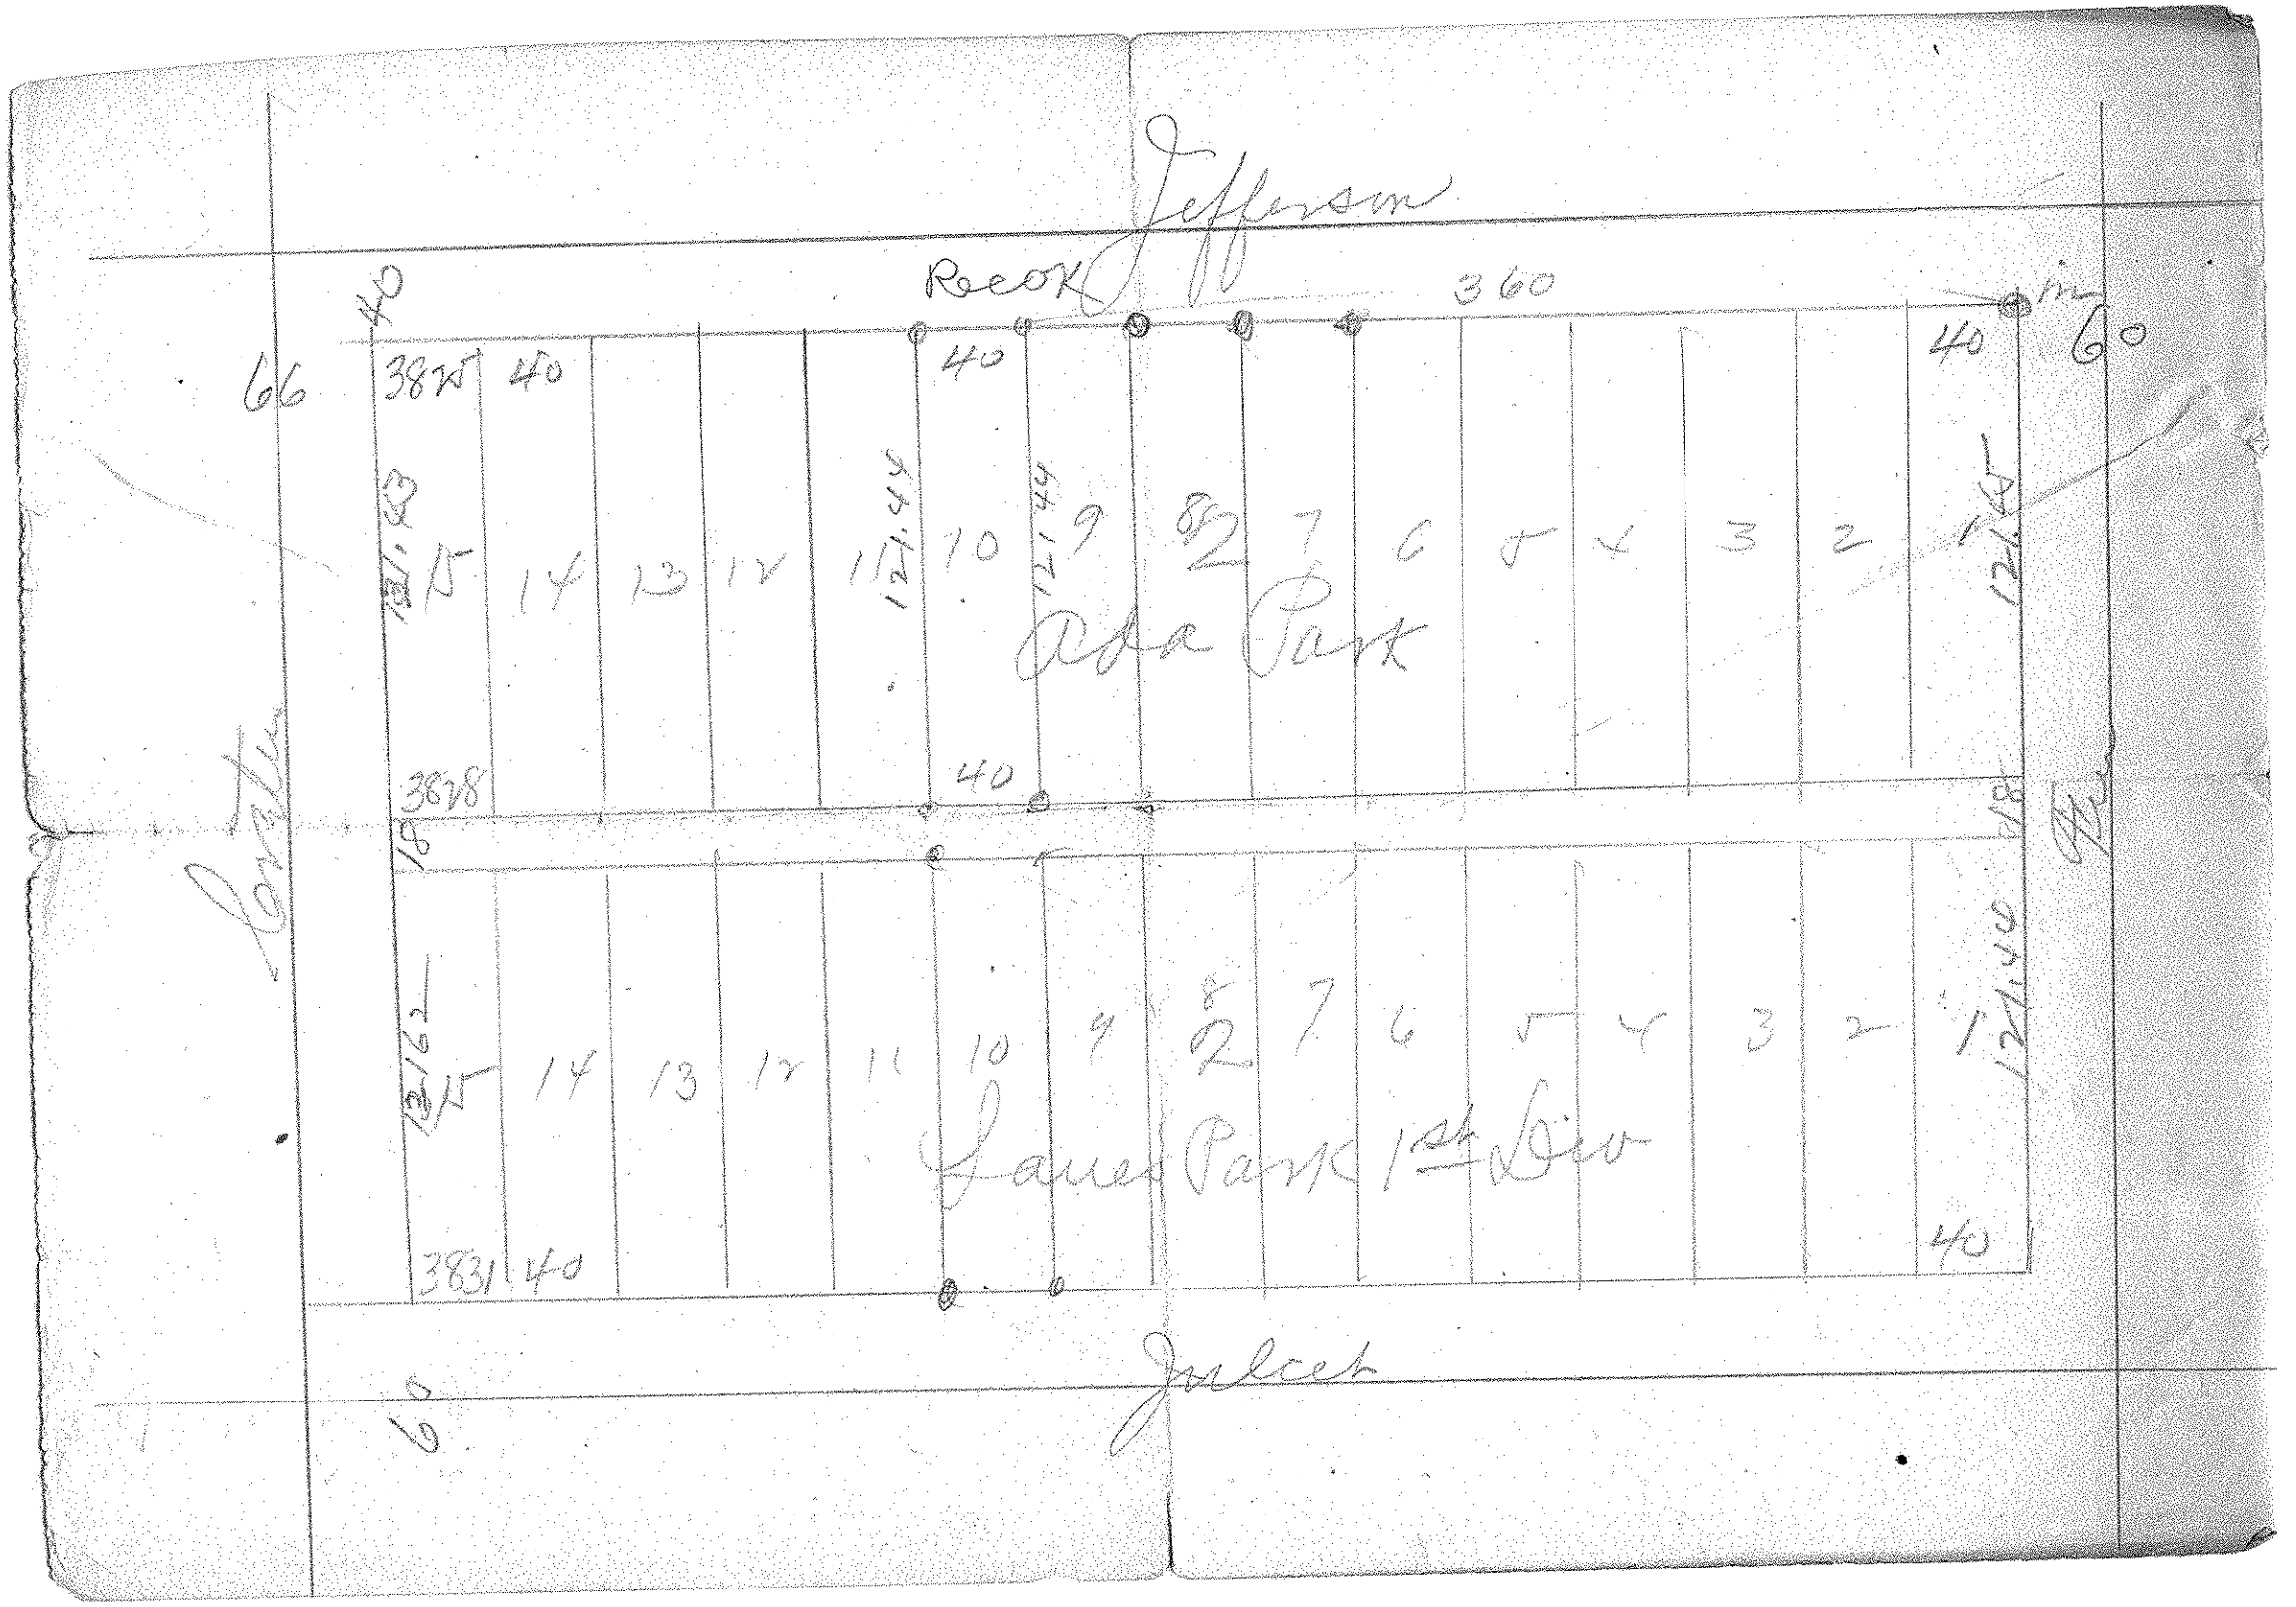
Jefferson
Rock
360
66
40
60
3825
40
40
40
121.43
15
14
13
12
11
121.44
10
121.44
9
8
2
7
6
5
4
3
2
1
121.45
Ada Park
3828
40
18
18
13162
15
14
13
12
11
10
9
8
2
7
6
5
4
3
2
1
121.40
Laurel Park 1st Div
3831
40
40
Julcet
60