2 28 23

LOTS 15. 16, 17 & 18 & SOUTHERLY 10 ft. LOT 2

AUDITOR SUBDIVISION.

No 40.

JOHN B. IRVINE, SURVEYOR.

MAY. 1. 1919.

Scale 20 ft. per inch.

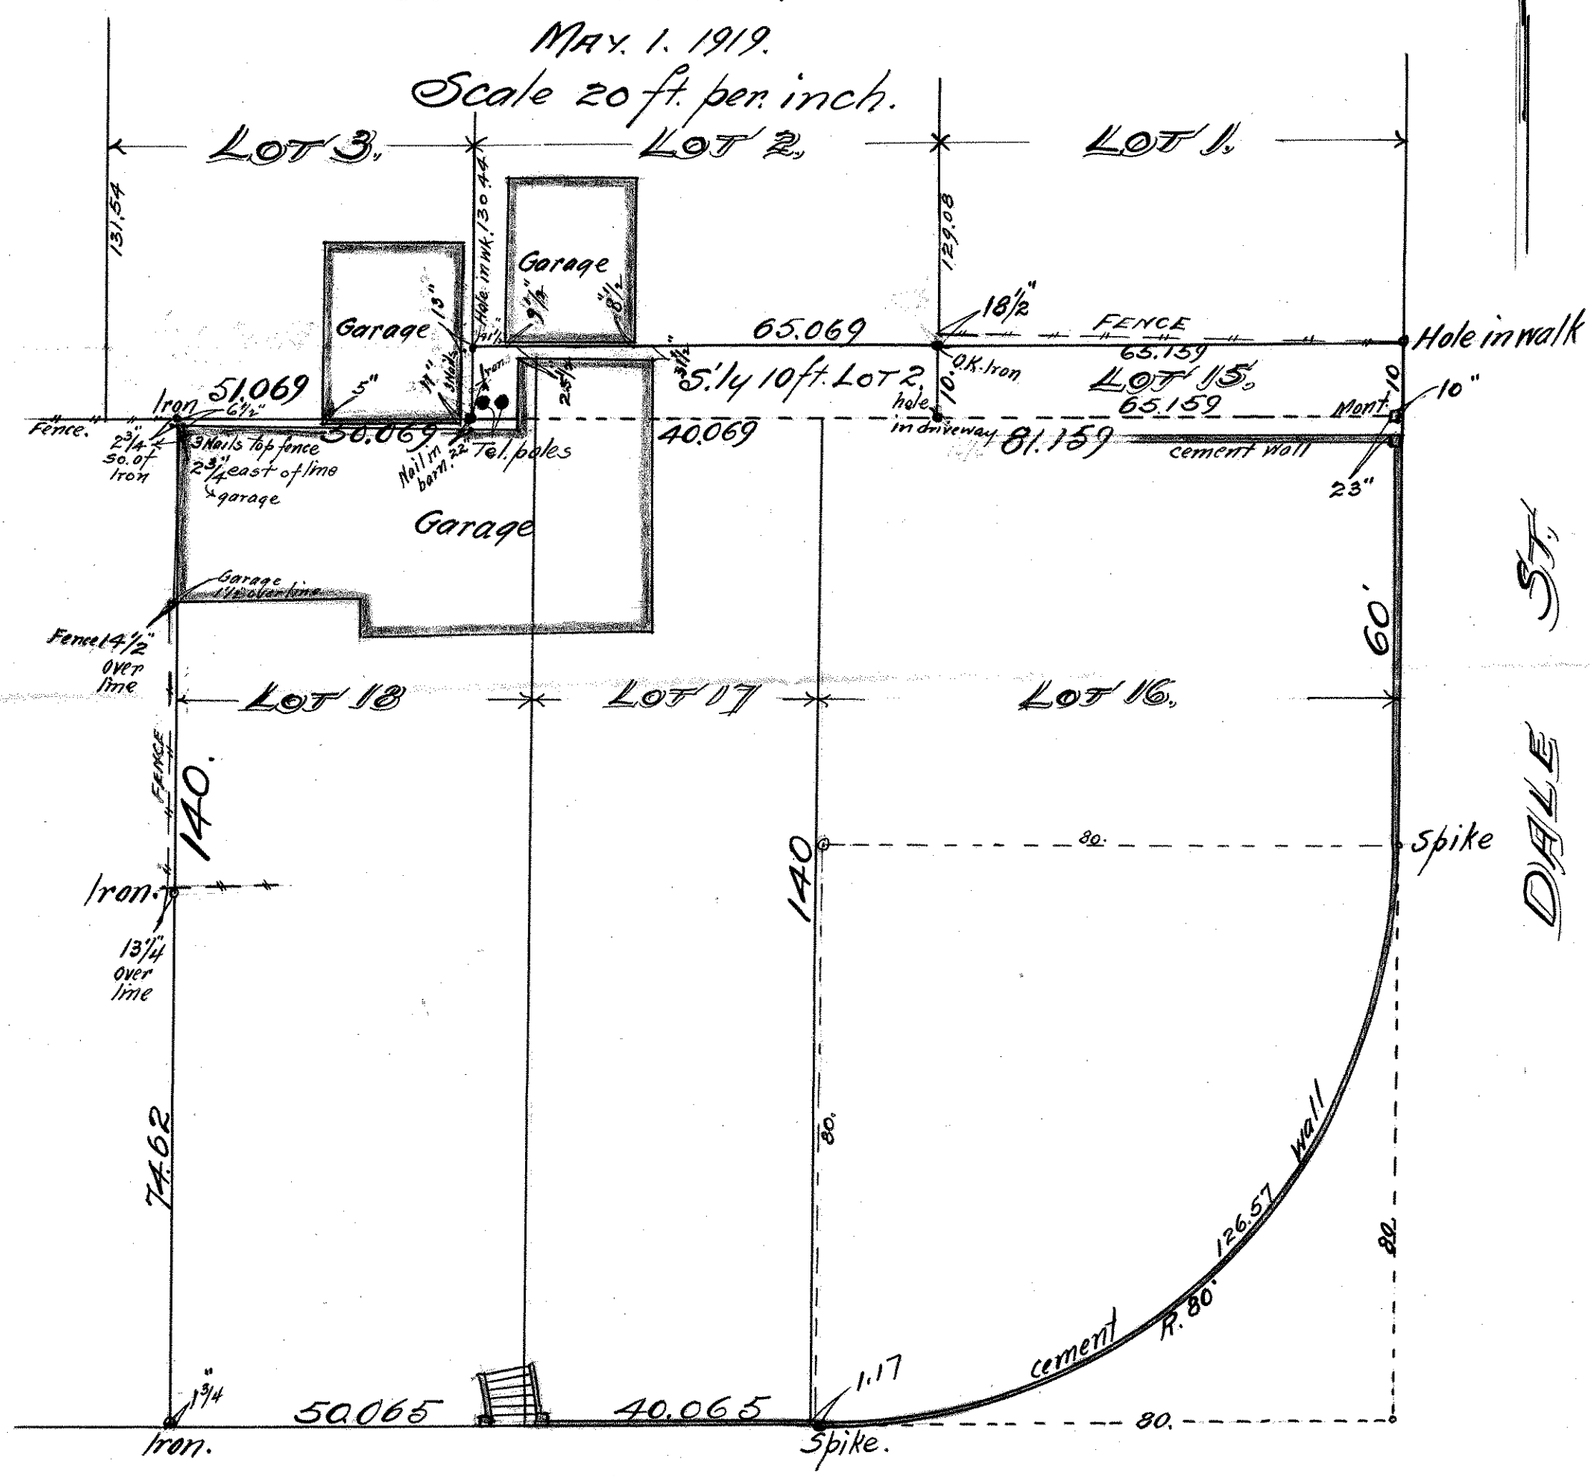

FAIRMOUNT AVE.