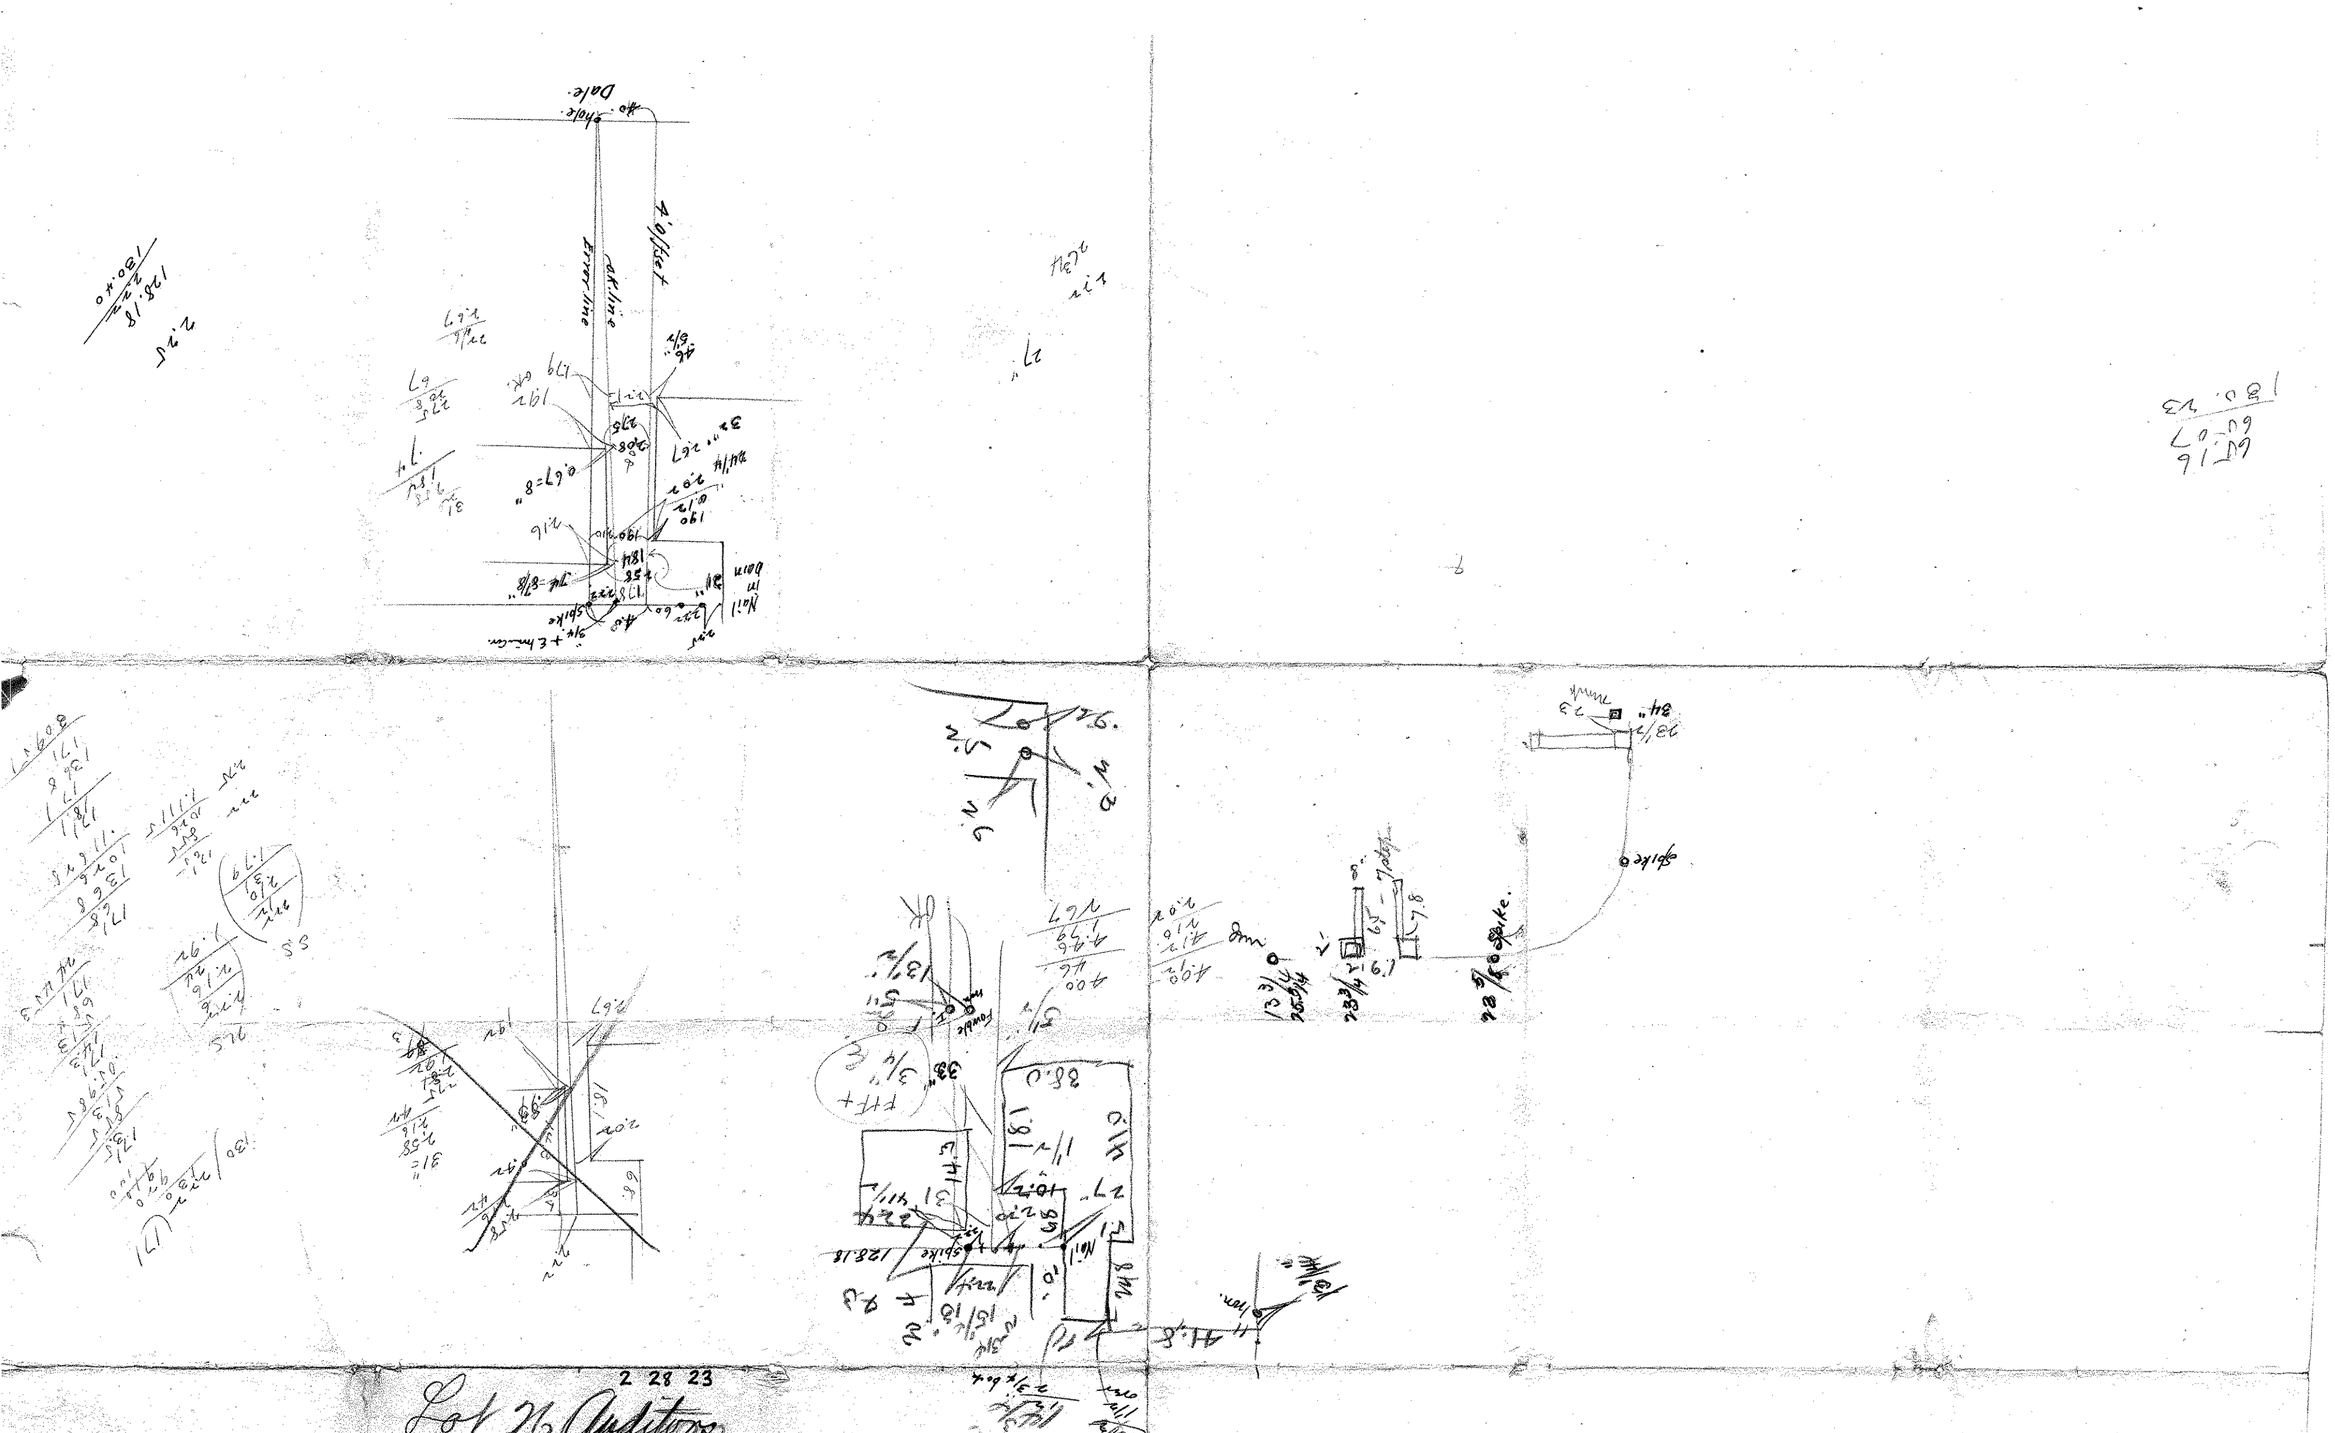

2 28 23

Lot 26 Auditors
Subd. No. 40
St Albans & Goodrich
Henry J. Knopf
369 W. Central
May 28 - 1909

JOHN B. IRVINE,
Civil Engineer and Surveyor
265 Mackubin Street
ST. PAUL, - MINN.