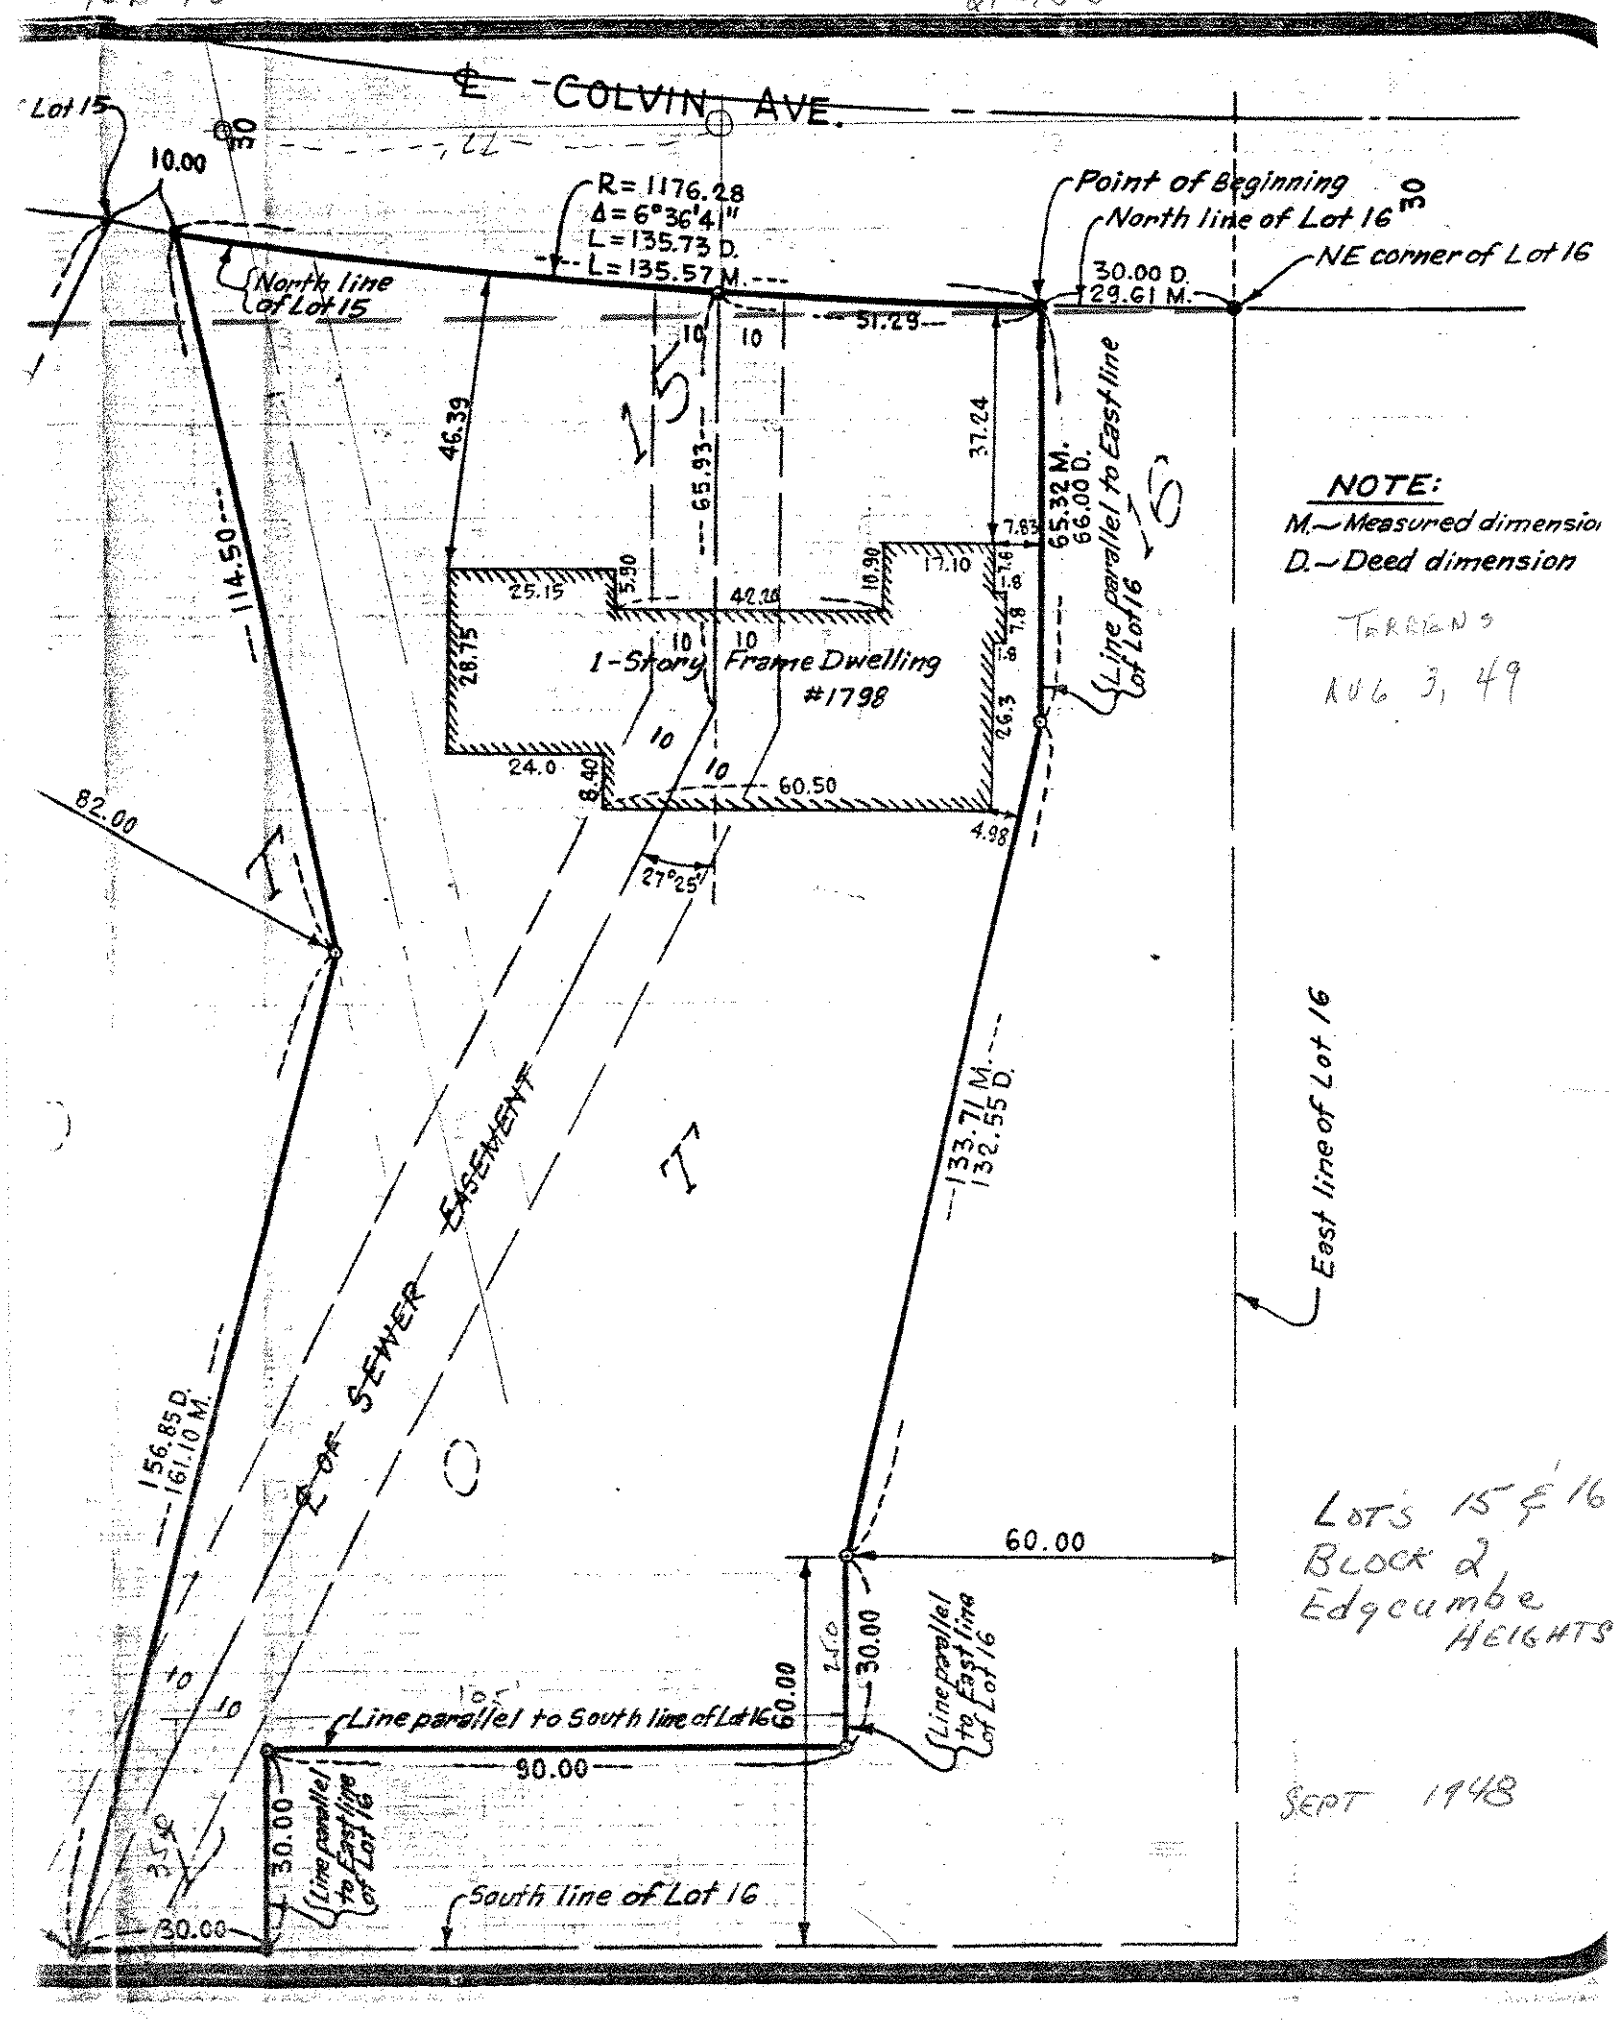

46L 78
21-153
℄ COLVIN AVE.
Lot 15
10.00
30
R=1176.28
Δ=6°36'41"
L=135.73 D.
L=135.57 M.
Point of Beginning
North line of Lot 16
30.00 D.
29.61 M.
NE corner of Lot 16
North line of Lot 15
51.29
46.39
65.93
37.24
65.32 M.
66.00 D.
Line parallel to East line of Lot 16
NOTE:
M.—Measured dimension
D.—Deed dimension
TORRENS
AUG 3, 49
114.50
25.15
5.90
42.20
10.90
17.10
7.83
28.75
1-Story Frame Dwelling
#1798
26.3
24.0
8.40
60.50
4.98
82.00
27°25'
133.71 M.
132.55 D.
East line of Lot 16
℄ OF SEWER EASEMENT
156.85 D.
161.10 M.
60.00
30.00
Line parallel to East line of Lot 16
Line parallel to South line of Lot 16
90.00
30.00
Line parallel to East line of Lot 16
South line of Lot 16
30.00
LOTS 15 & 16
BLOCK 2
Edgcumbe
HEIGHTS
SEPT 1948