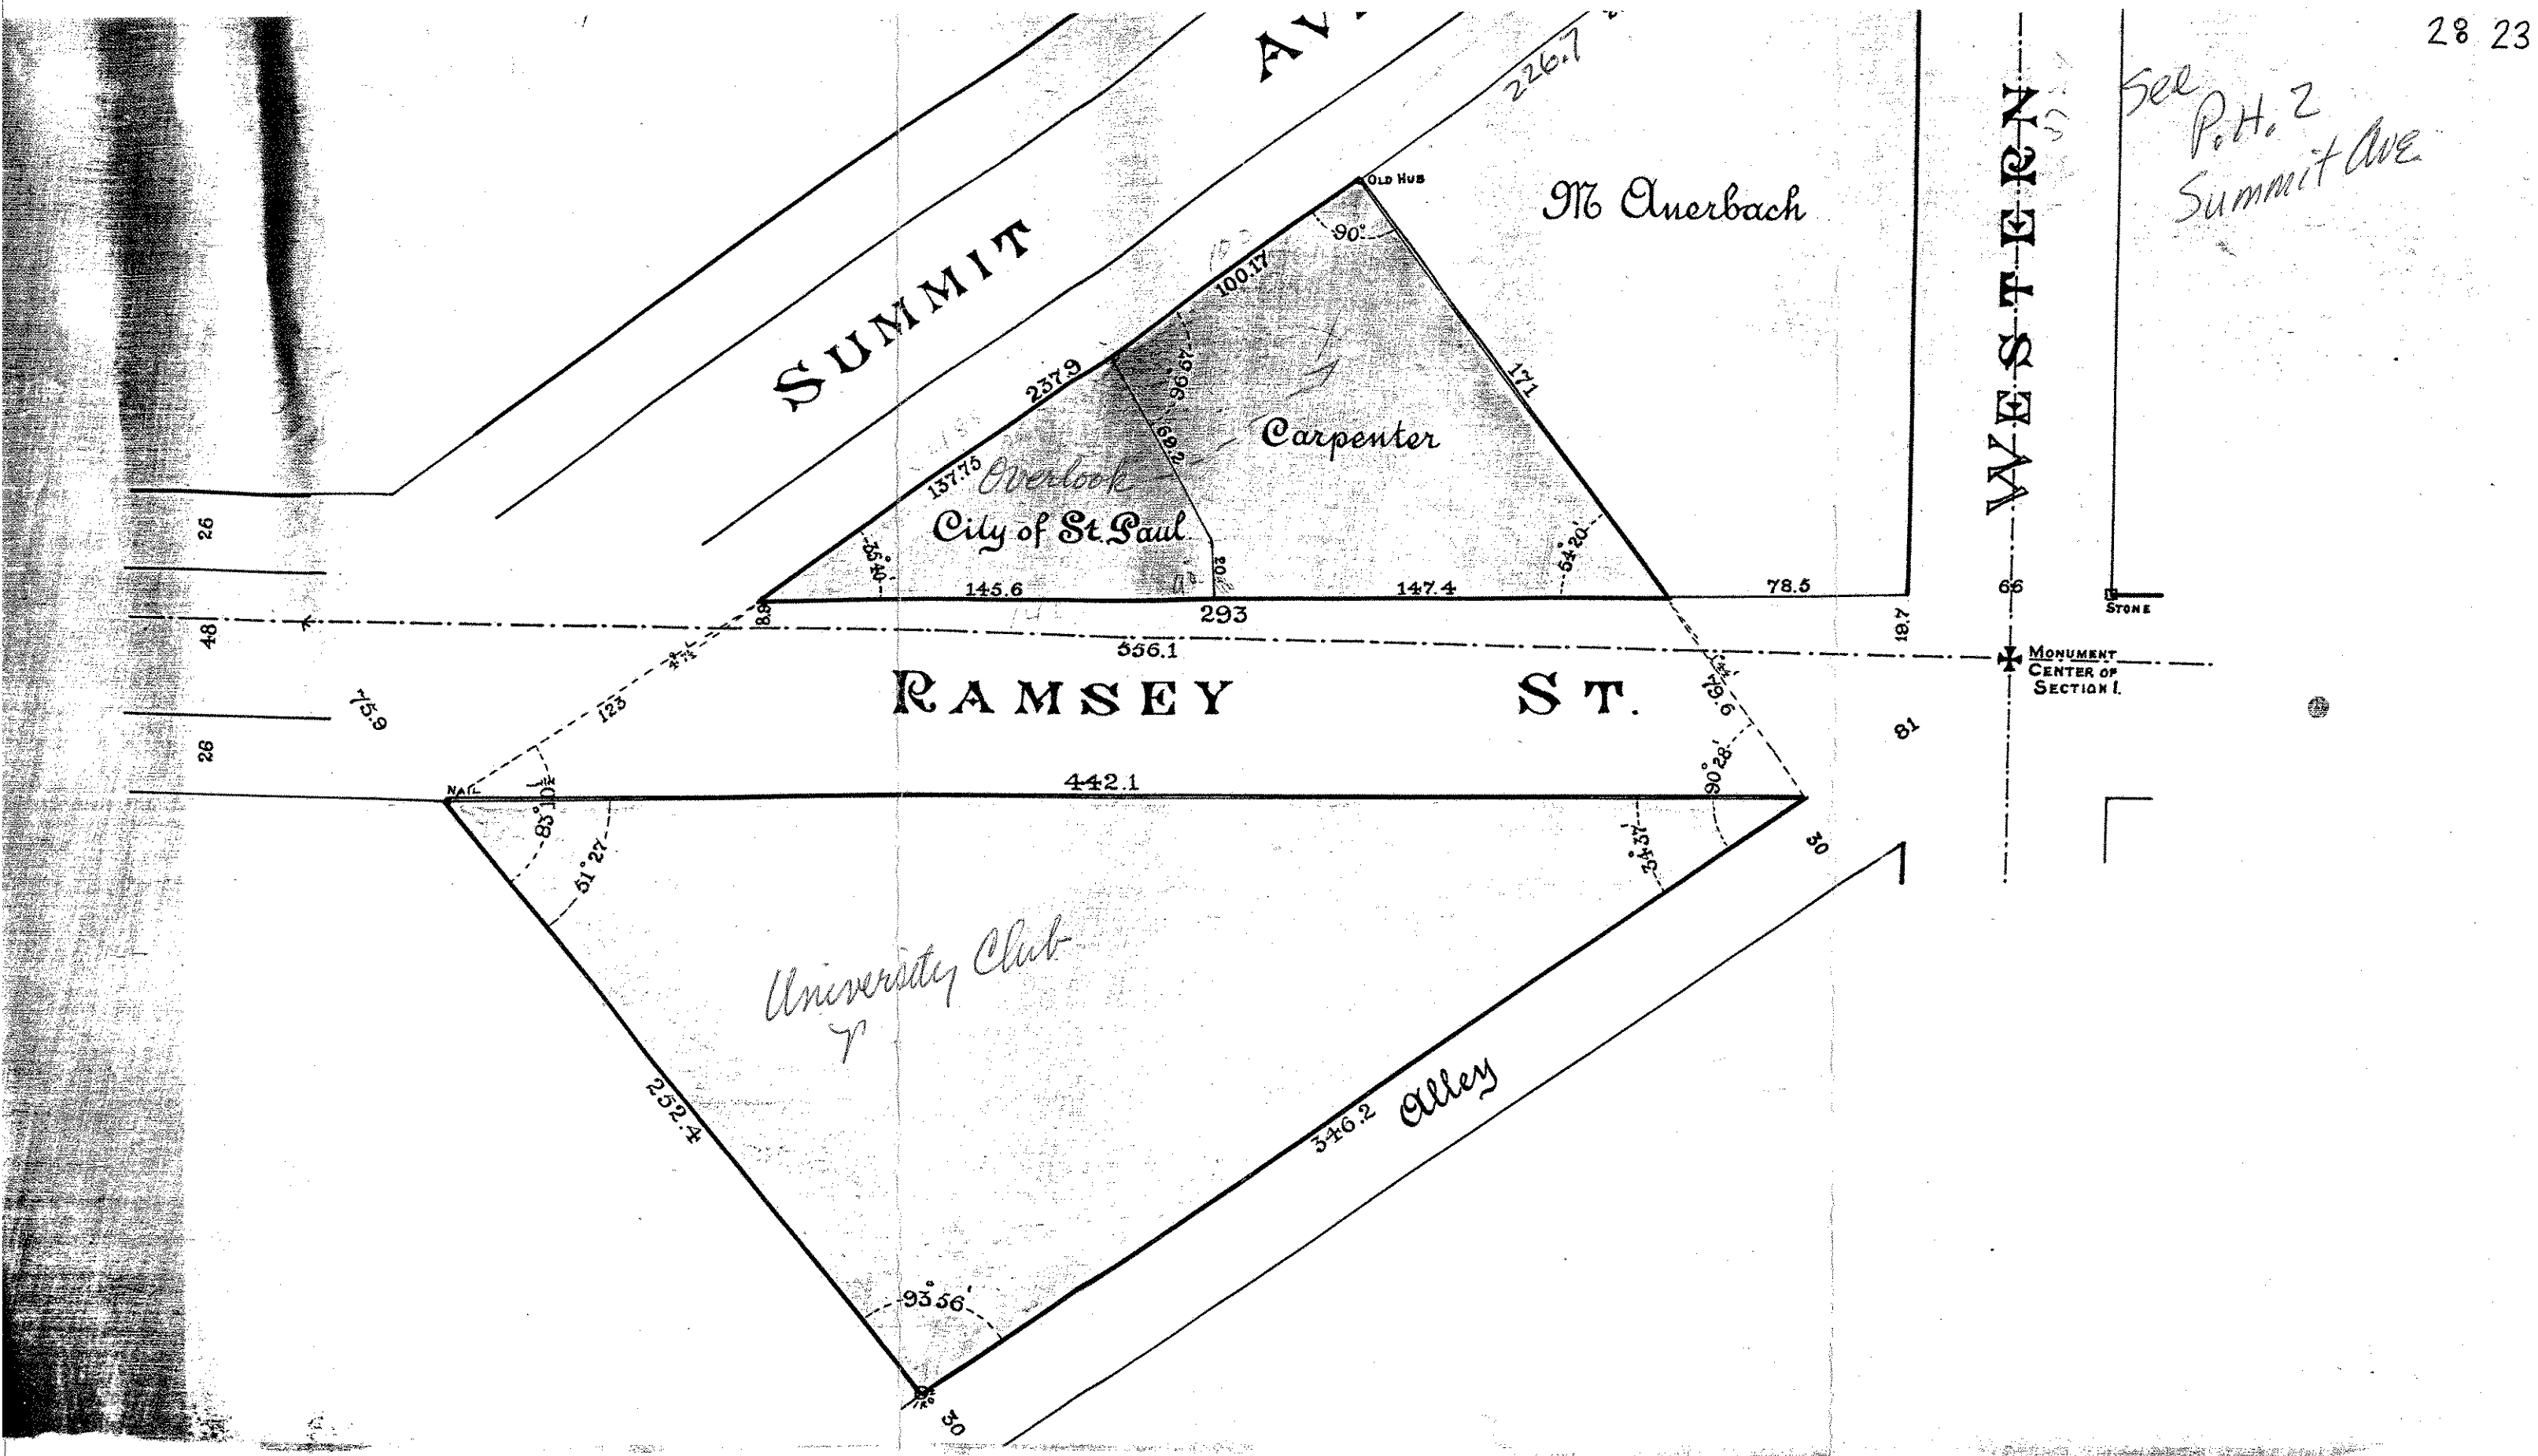
28 23
See P.H. 2 Summit Ave
SUMMIT
AV
226.7
OLD HUB
M Auerbach
90°
100.17
96.67
69.2
237.9
137.75
Overlook
City of St. Paul
Carpenter
171
145.6
147.4
78.5
293
556.1
RAMSEY ST.
WESTERN
66
STONE
MONUMENT CENTER OF SECTION I.
19.7
81
26
48
26
75.9
123
NAIL
442.1
83°10'
51°27'
79.6
90°28'
34°37'
30
University Club
252.4
346.2
Alley
93°56'
30