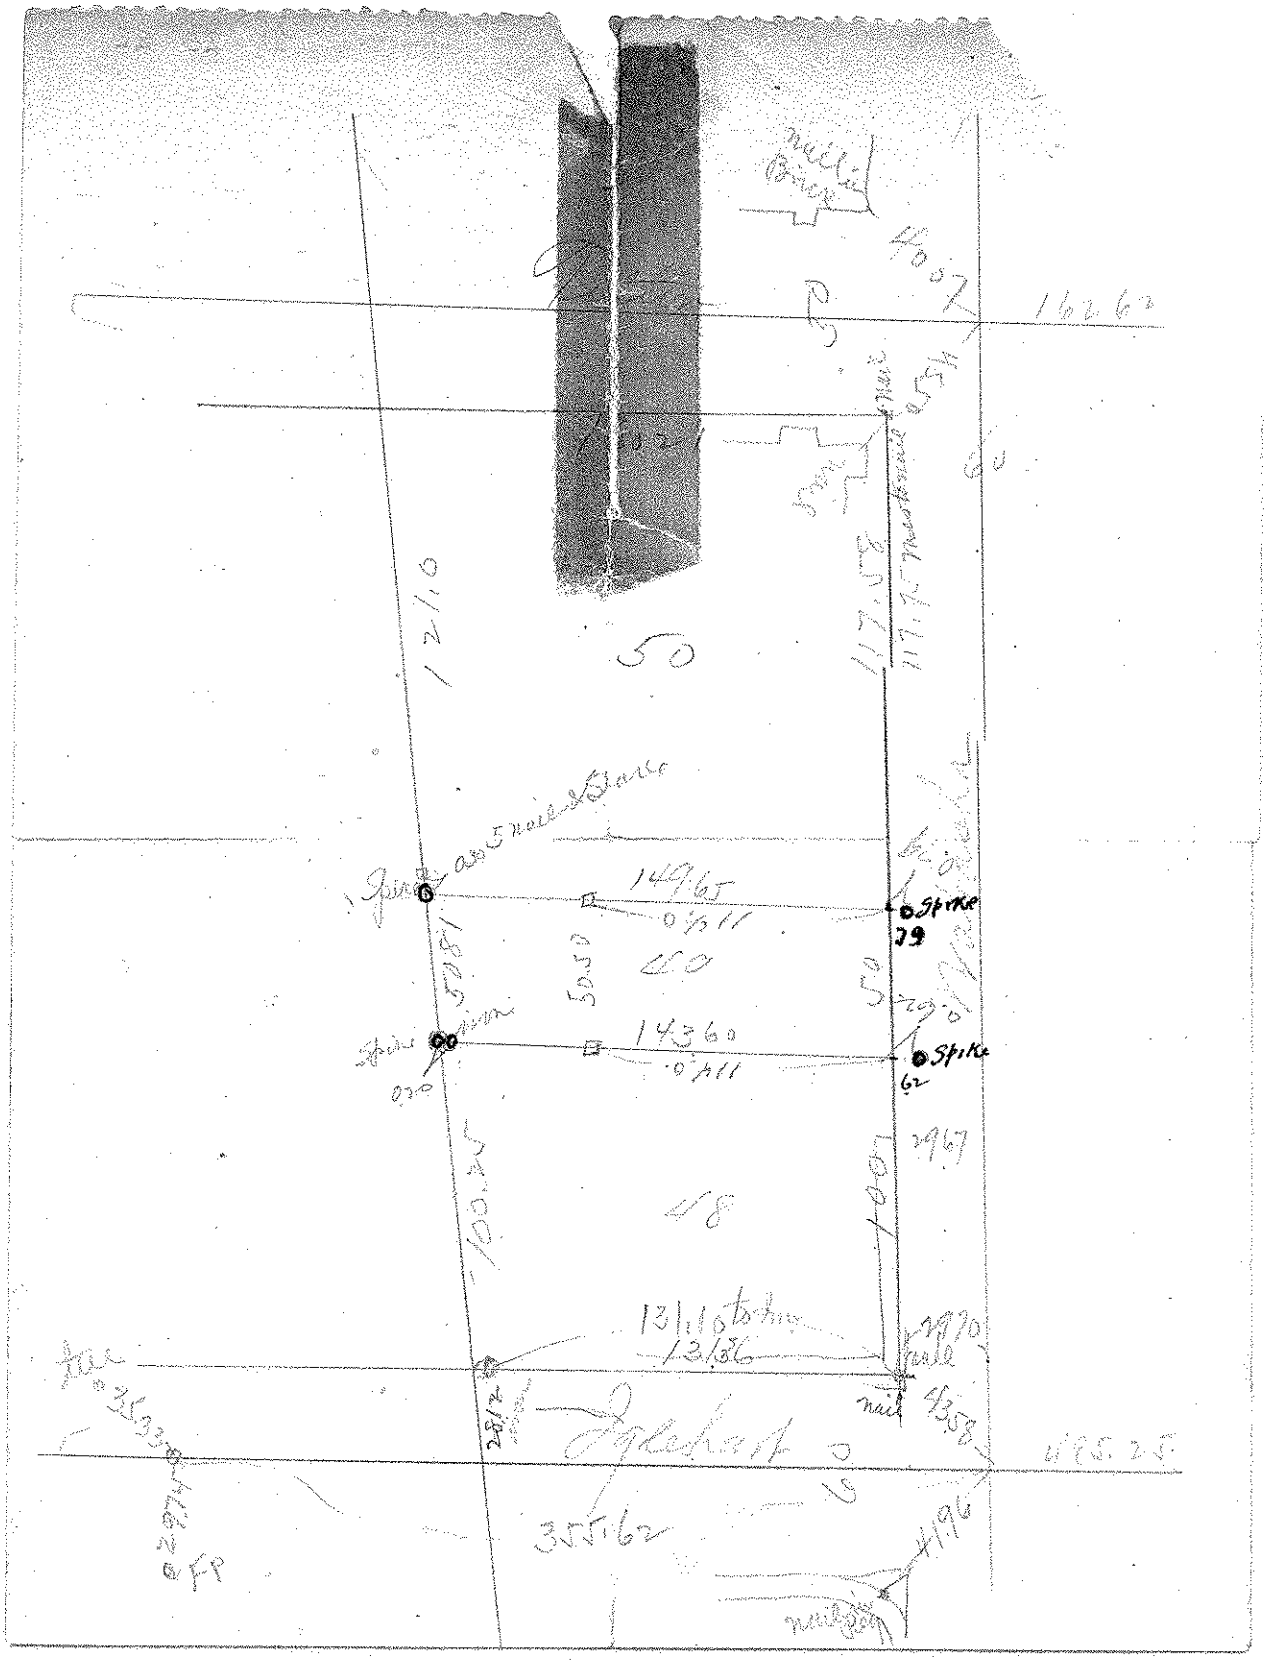

162.62
121.0
50
117.58
117.75 meters
149.65
0.411
Spike
79
40
50.50
143.60
0.411
Spike
62
29.67
48
100.25
131.10 to line
131.36
2970
nail
4358
485.25
355.62
41.96
nail