


12/16/55

65827

Remond


22913

1007
1007
1007

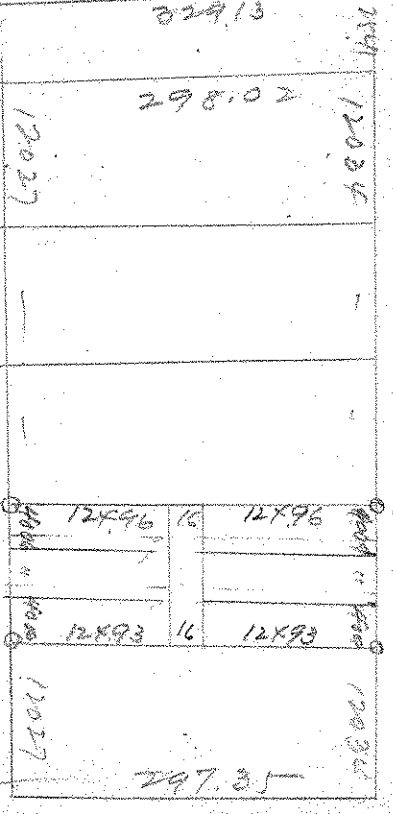


11646
11646
11646
13280.70
59820
66140
TP 8249
817.0 TP

Barman
817.0 TP

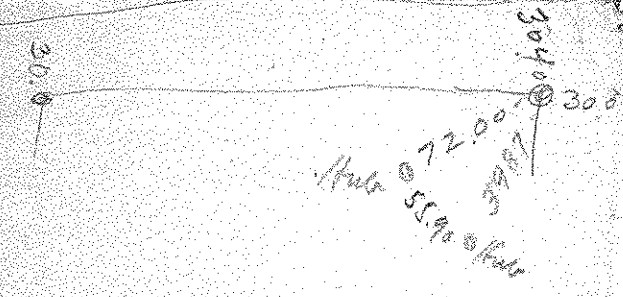

1321.60
Remond

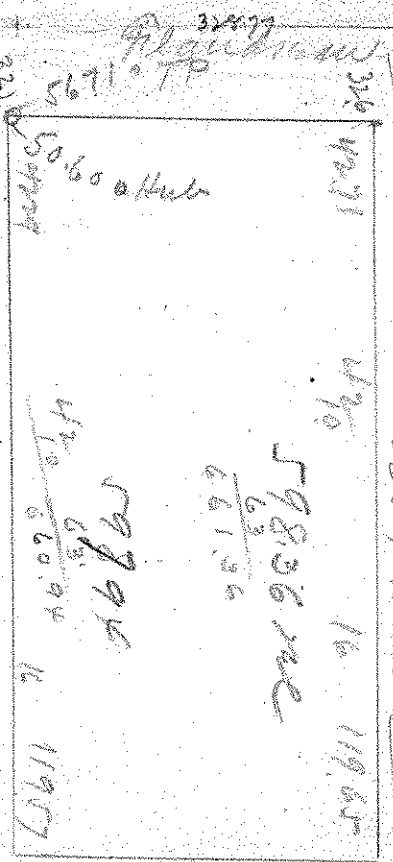

1322.82
66390.70
1322.82
817.0 TP

Conno S. P. 1322.82

Helen 660.19 pro
661.87 pro
1326.38

616.05
1313.71

Remond
32842